

Name Leo Hayes

Service No. 64

Address 6 Calvin Street

Location

Kind of Pipe

Size

Size of Main

Repair - Renewal - New Service

COM. 7-13-53

Location

Date	Material	Amount	Total	Date	Amount
6/2/53	Labor	38 40		4-13-53	Deposited 125
	10% overhead	3 84	42 24	7-13-53	Refunded (44 38)
	42' - 6" sewer pipe @ .342		14 36		80 62
	joint compound		2 52		
	4 hrs. town shovel @ 5.00		20 00		
	2 hrs. trucking		<u>1 50</u>		
			80 62		
	Labor				

TOWN OF LEXINGTON—DEPT. OF PUBLIC WORKS
SEWER DIVISION

DATE.....

NO.


The undersigned applies for the construction of a particular sewer connecting No.....
Street and hereby agrees to comply with the Rules and Regulations governing the construction and use of Particular
Sewers, as now or at any future time established by the Board of Selectmen.

Am't of estimate \$.....

Am't Paid \$.....

..... Owner

Sketch of Service Here

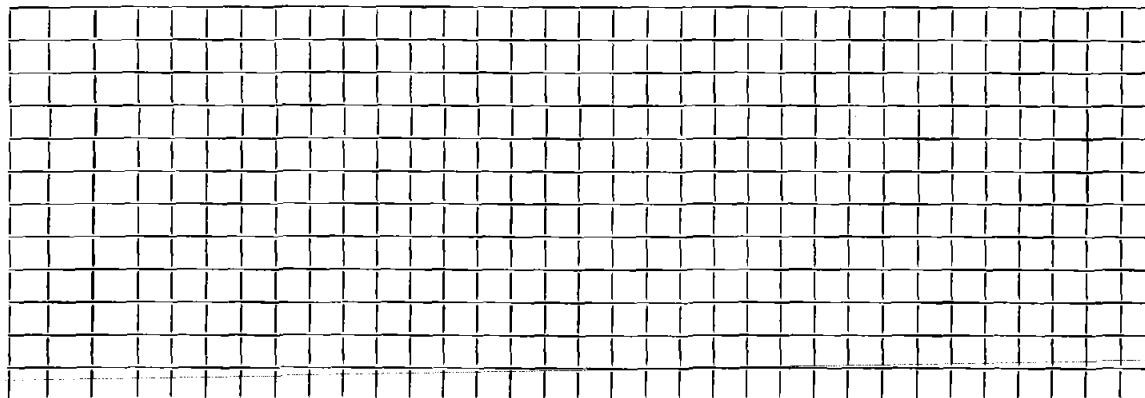

Connection made in..... Street.

Work completed.....19..

Remarks: