

Name

Service No.

Address 139 Cambridge Concord Highway

Location

Kind of Pipe

Size

Size of Main

Repair—Renewal—New Service

Location

Date

Material

Amount

Total


Date

Amount

DATE \_\_\_\_\_

TOWN OF LEXINGTON — BOARD OF PUBLIC WORKS  
SEWER DIVISION

Sketch of Service Here **139**

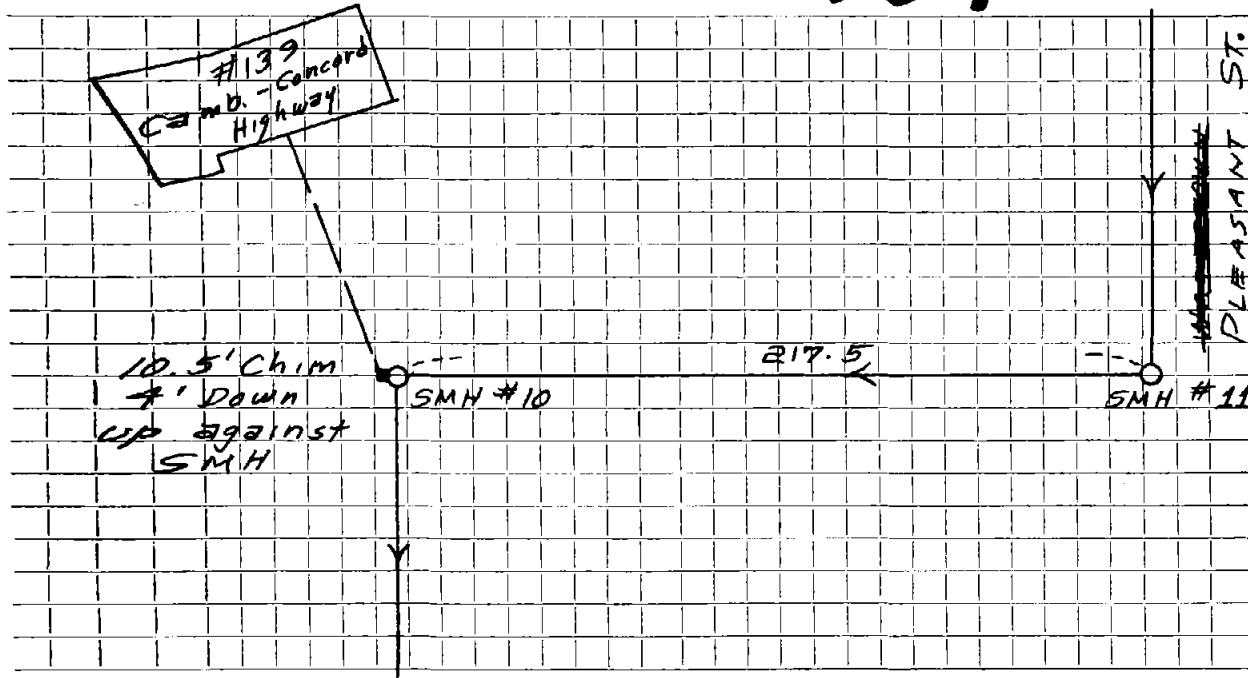

Connection made in ..... Street. Work completed .....

Remarks: .....  
.....  
.....