
Name	Graham				Service No.	
Address	9 Camellia Place			· · ·		
		·	·	Location		
Kind of Pipe		Size of Main				
RepairRe	enewal—New Service				Location	
Date	Material	Amount	Total	Date		Amount
				-		
	···			<del> </del>		
-	<del></del>					
	<del></del>			6-29-72	Sewer Block	
				0 01 12	June 1000	
10781. м. я.			<u> </u>			

DATE				
		_	-	
	 •		_	

## TOWN OF LEXINGTON — BOARD OF PUBLIC WORKS SEWER DIVISION

## Sketch of Service Here

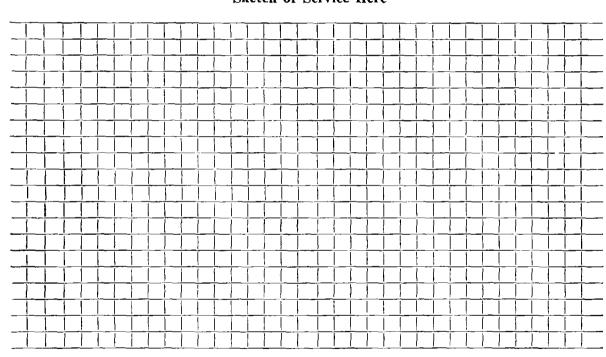

Connection made in Street.	Work completed
Remarks:	
······································	