

Name Frederick C. Hadley

Service No. 153

Address 4 Candlewick Close

Lexington

Location

Kind of Pipe

Size

Size of Main

~~REPAIR~~ Renewal - New Service

Cem. 11-24-52

Location

Date	Material	Amount	Total	Date	Amount
10/14/52	Labor	50 83		10-8-52 Deposited	125 -
10/15/52	"	14 54	65 37	11-24-52 Refunded	(3 49
	10% overhead		6 54	9-4-79 Renewal	121 51
	50' - 6" sewer pipe @ .342		17 10	10' 6" Transite	
	joint compound		3 00	1 6"-5' Nipple	
	4 hrs. Littlefield shovel		28 00	1 6"-3' Nipple	
	2 hrs. trucking		1 50	1 6"-1' Nipple	
	RENEWAL DEFLICE #3413		121 51	1 6"-90° Transite Elbow	
9-5-79	30' 6" Transite pipe			1 6" X 8" Saddle	
	10' 4" Cast Iron pipe				
	Labor			8-15-79	Costs 30' - 40'

TOWN OF LEXINGTON—DEPT. OF PUBLIC WORKS

SEWER DIVISION

DATE

NO.


The undersigned applies for the construction of a particular sewer connecting No.
Street and hereby agrees to comply with the Rules and Regulations governing the construction and use of Particular
Sewers, as now or at any future time established by the Board of Selectmen.

Am't of estimate \$.....

Am't Paid \$.....

..... Owner

Sketch of Service Here **4**

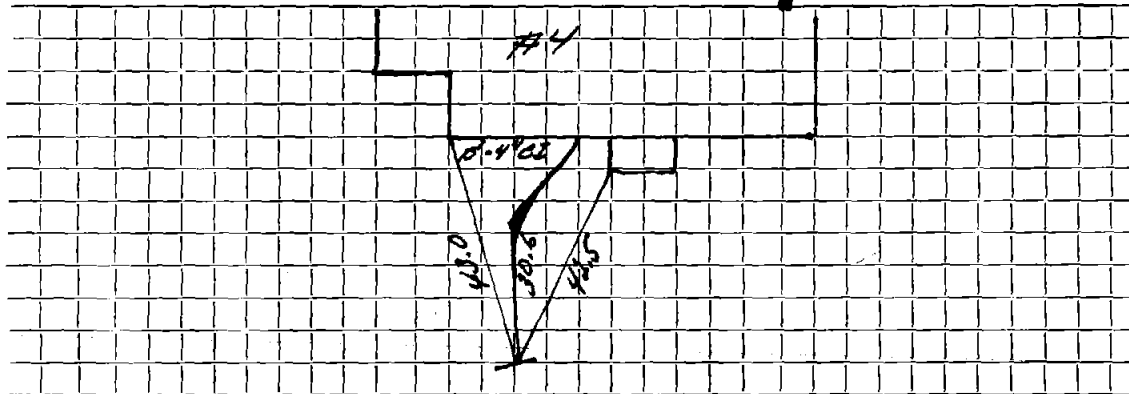

Connection made in Street.

Work completed 19..

Remarks: