

Name **Beatrice Button**

Service No. **58**

Address **5 Candlerwick Close**

Location

Kind of Pipe

COM. 9-29-52

Size

Size of Main

~~Repair~~ ~~Renewal~~ - New Service

Location

Date	Material	Amount	Total	Date	Amount
9/11/52	Labor	76 97		4-25-52	Deposited 200 00
9/12/52	Labor	37 59		9-29-52	Refunded 24 06
	10% Overhead	11 46	126 02		175 94
	74' - 6" sewer pipe @.342		25 31		
	joint compound		4 44		
	2 2/3 hr. Littlefield shovel @.7		18 67		
	2 hr. trucking		1 50		
			175 94		
				12-21-66	Debris
	Labor				

**TOWN OF LEXINGTON—DEPT. OF PUBLIC WORKS**  
**SEWER DIVISION**

DATE.....

NO. ....

The undersigned applies for the construction of a particular sewer connecting No.....  
Street and hereby agrees to comply with the Rules and Regulations governing the construction and use of Particular  
Sewers, as now or at any future time established by the Board of Selectmen.


Am't of estimate \$. ....

Am't Paid \$. ....

..... Owner

---

**Sketch of Service Here**

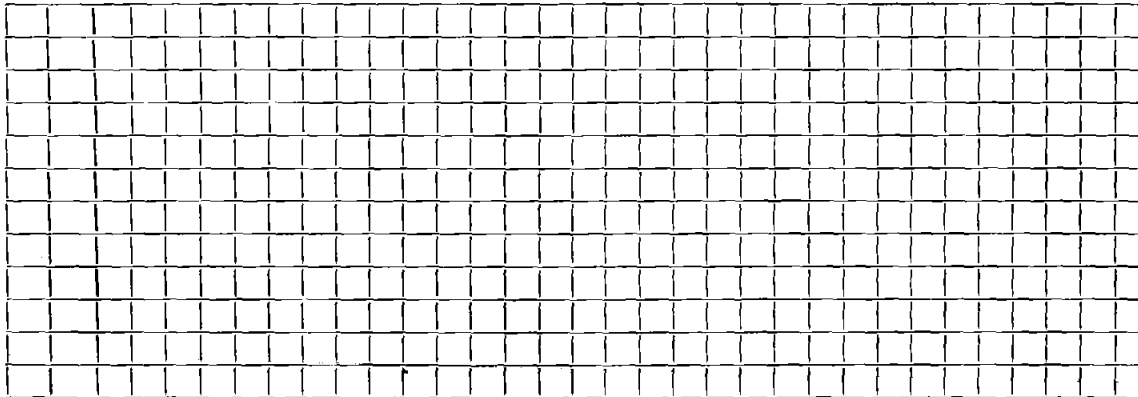

Connection made in ..... Street.

Work completed.....19..

Remarks: