

Service No.

Name
Address CAPTAIN PARKER ARMS # 364

Location

Kind of Pipe PVC
Size 2"
Size of Main 8"

(Repair—Renewal—New Service)

Location

Date	Material	Amount	Total	Date	Amount
------	----------	--------	-------	------	--------


8/9 88	68.5' 2 6" PVC 220 BEND				
--------	----------------------------	--	--	--	--

DATE _____

TOWN OF LEXINGTON — BOARD OF PUBLIC WORKS
SEWER DIVISION

CAPTAIN PARKER ARMS

Sketch of Service Here

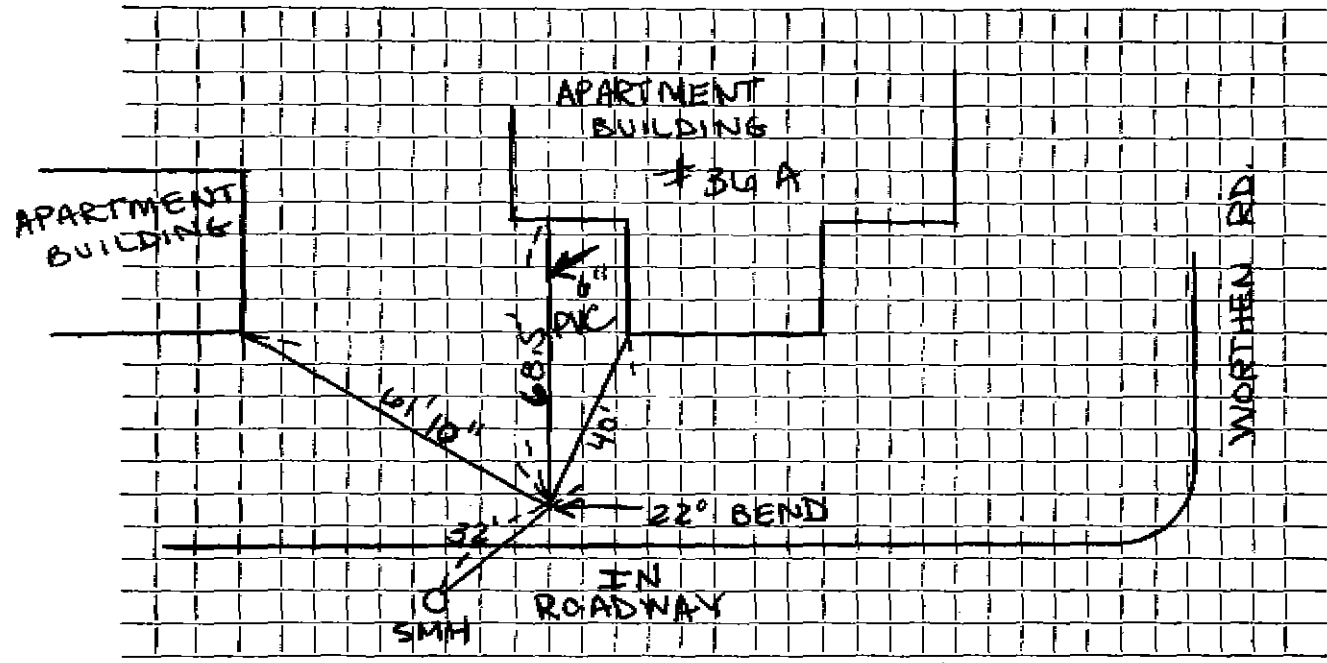

Connection made in Street. Work completed

Remarks: NOTE: NO OUTSIDE TIES