

Name NORTH SHORE DEVELOPMENT

Service No.

Address #2 CARL ROAD

Location

Kind of Pipe

Size

Size of Main

Repair—Renewal

New Service

PERMIT NO. 0976-MICHAEL RUGGERI

Location

Date

Material

Amount

Total

Date

Amount

JUNE 19, 1997

7.5' - 4" ϕ PVC

19' - 6" ϕ PVC


1 - 22° ELBOW

1 - WYE CLEANOUT

DATE JUNE 19, 1997

TOWN OF LEXINGTON — BOARD OF PUBLIC WORKS
SEWER DIVISION

Sketch of Service Here

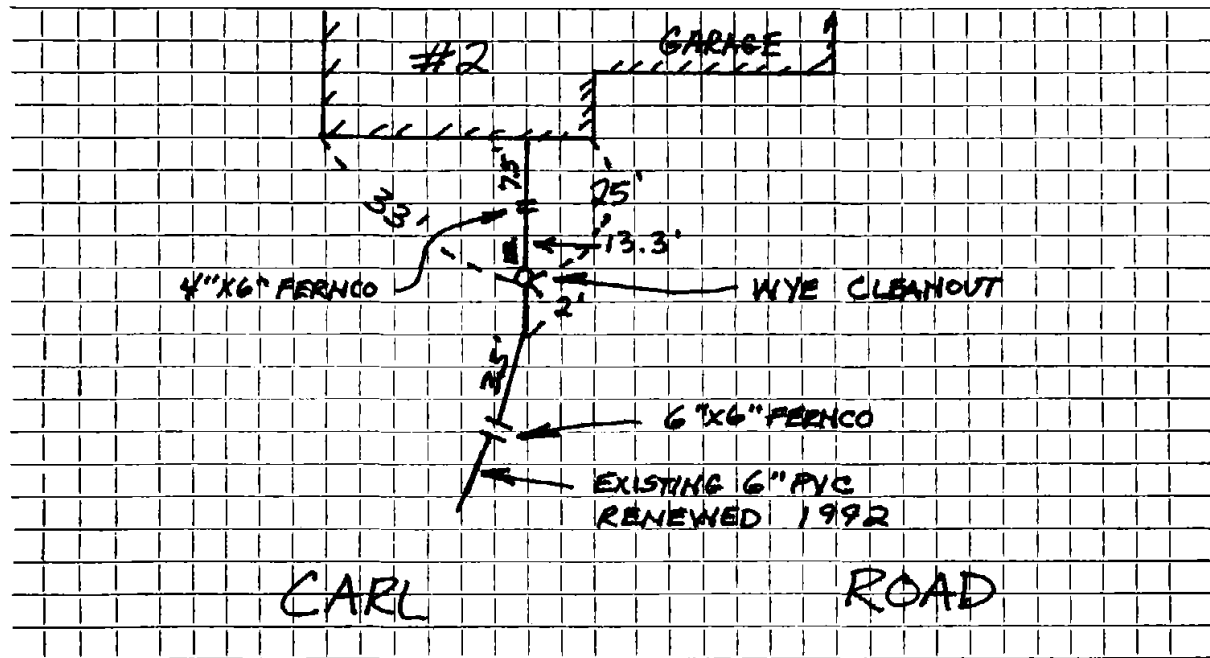

Connection made in Street. Work completed

Remarks: Original Service 8-27-73

BOOK 97-2

J.W.