

Name Robert Joslyn

Service No. 144

Address #4 CARL RD.

Location

Kind of Pipe A.C.

Size 6"

Size of Main 8"

Repair—Renewal—New Service Trebino #2411

Location NOV 19 1973


Date	Material	Amount	Total	Date	Amount
<del>10/27/73</del>	23' @ 8.90	\$204.70		10-16-73	Deposit 204.70
10/16/73	15' 6" Transite pipe				
	10' 4" Cast Iron pipe			8-27-73	
					23' 6" Transite
6/9/83	INSTALLED NEW 4" x 6" DONUT 9' OUT FROM HOUSE				
	VALERI CONST. #4175				
				1-2-83	Pipe appears to be broken 13' out from house

DATE \_\_\_\_\_

TOWN OF LEXINGTON — BOARD OF PUBLIC WORKS  
SEWER DIVISION

Sketch of Service Here

4

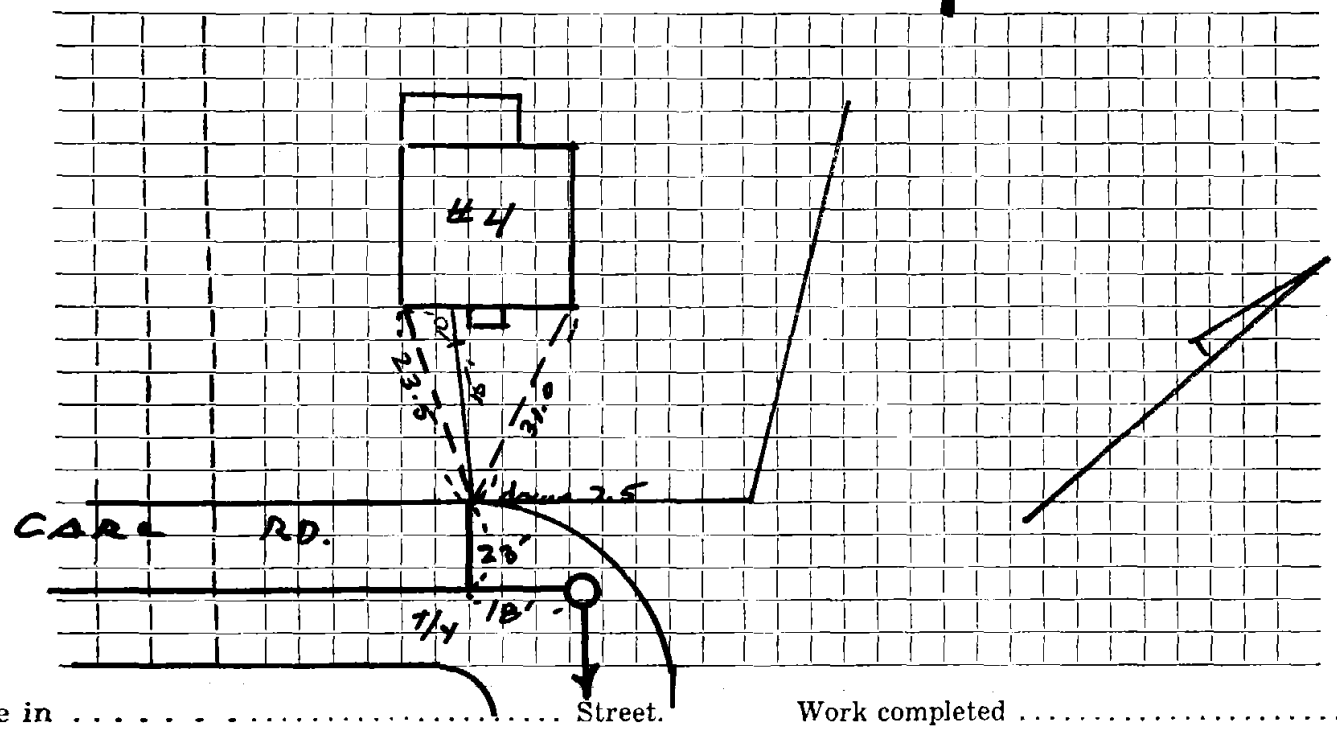

Connection made in ..... Street. Work completed .....

Remarks: .....  
.....  
.....