


DATE 10/15/19

TOWN OF LEXINGTON — BOARD OF PUBLIC WORKS

SEWER DIVISION

Sketch of Service Here

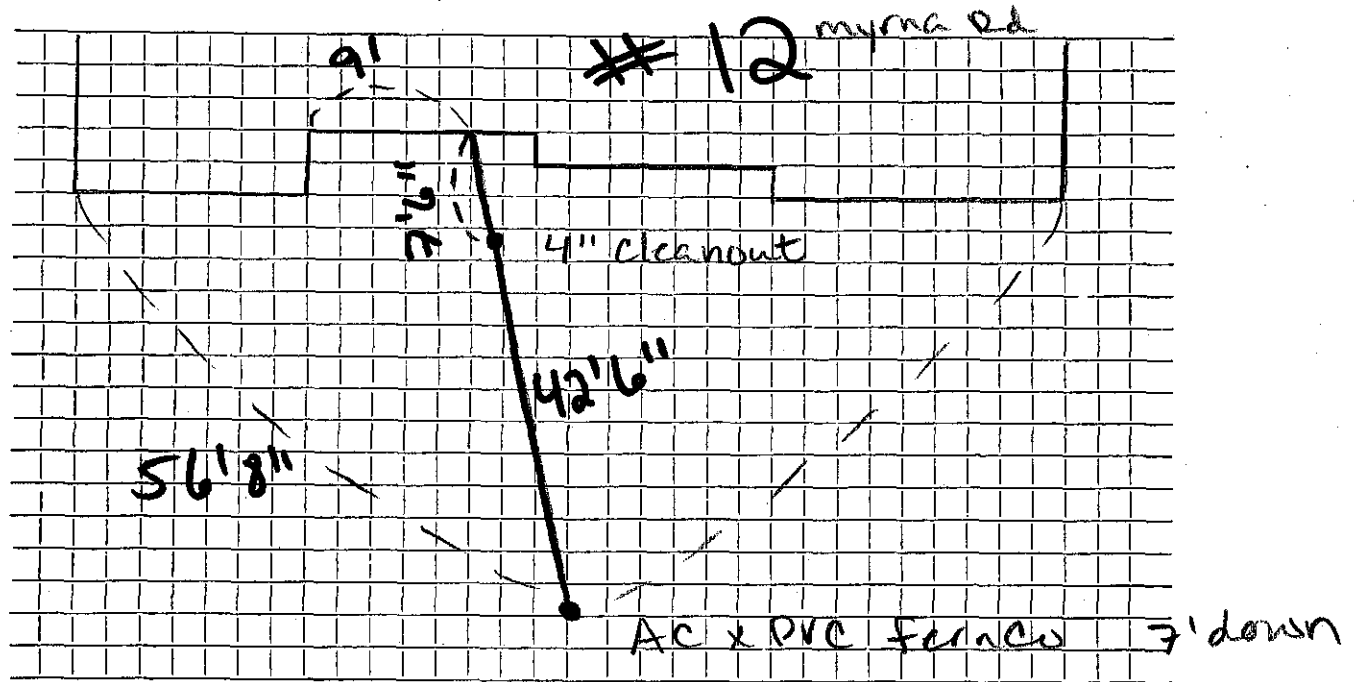

Connection made in ... Carl Rd ... Street. Work completed

Remarks:
.....
.....