




DATE \_\_\_\_\_

TOWN OF LEXINGTON — BOARD OF PUBLIC WORKS

SEWER DIVISION

Sketch of Service Here **12**

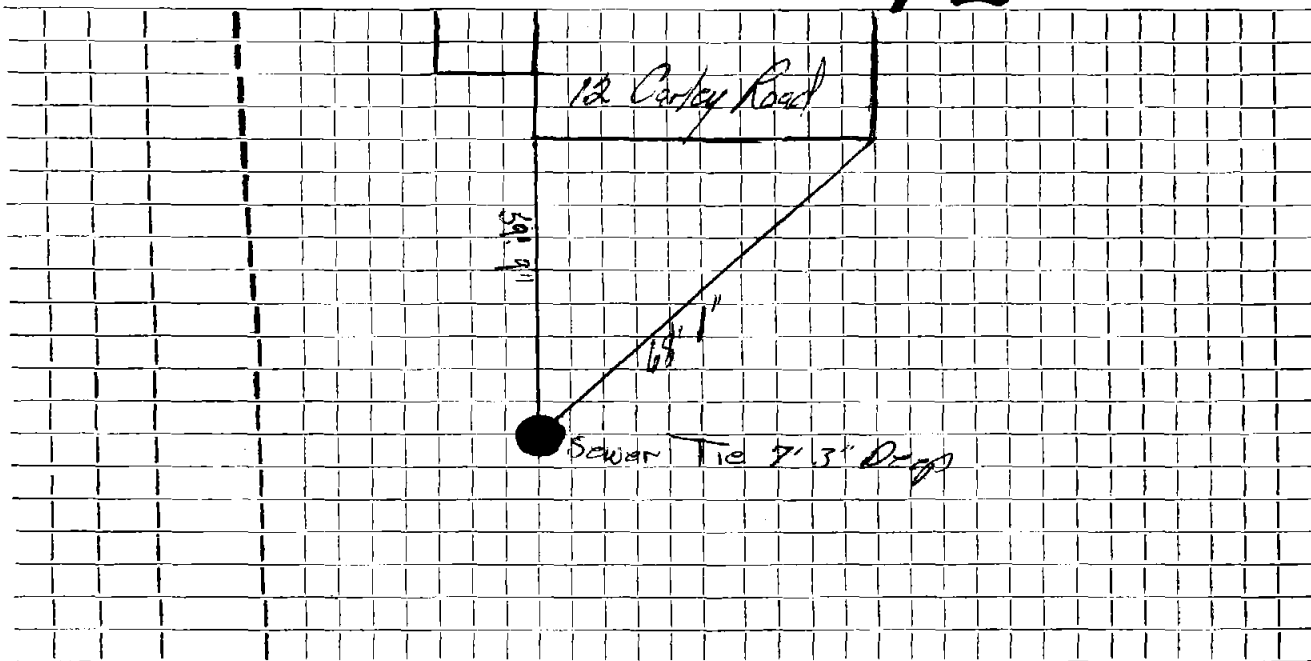

Connection made in \_\_\_\_\_ Street. Work completed \_\_\_\_\_

Remarks: Original - Service 7-48 \_\_\_\_\_

\_\_\_\_\_  
\_\_\_\_\_

