

Name A. J. Comeau

Service No. 124

Address 17 Carley Rd.

Lexington

Location

Kind of Pipe

COM. 9-22-52

Size

Size of Main

~~Repair~~ ~~Renewal~~ - New Service

Location

Date	Material	Amount	Total	Date	Amount
8/27/52	Labor	39 35		8-19-52	Deposited 225 00
	10% Overhead	3 94	43 29	9-22-52	Refunded (109 23)
	50' - 6" sewer pipe @.342		17 10		115 77
	1 - 6" elbow @1.88		1 88	8-19-68	Renewal
	joint compound		3 00		17' 6" Transite
	7 hrs. Littlefield shovel		49 00		
	2 hrs. trucking		1 50		
5-13-66	Renewal		115 77		
	10' 6" Transite				
	1 6" Adapter				
8-22-68	<del>Renewal</del>				
	15' 6" Transite				
	Labor				
				8/8	
				5-12-66	Repts
				12-13-65	PLUMBER TOOK CARE OF IT.
				1-5-66	ROOTS - 4-16-66 - ROOTS

**TOWN OF LEXINGTON—DEPT. OF PUBLIC WORKS**  
**SEWER DIVISION**

DATE.....

NO. ....

The undersigned applies for the construction of a particular sewer connecting No.....  
Street and hereby agrees to comply with the Rules and Regulations governing the construction and use of Particular  
Sewers, as now or at any future time established by the Board of Selectmen.


Am't of estimate \$.....

Am't Paid \$.....

..... Owner

Sketch of Service Here

17

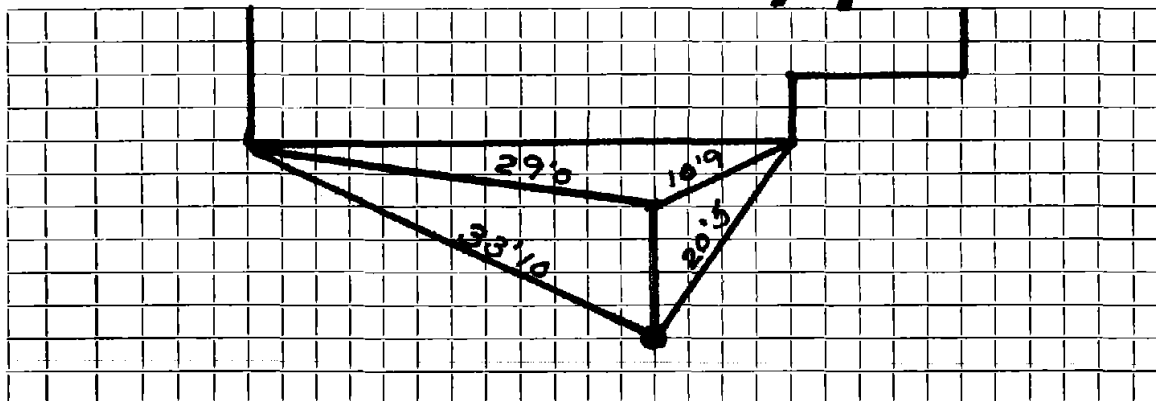

Connection made in..... Street.

Work completed.....19..

Remarks: