

Name ~~Custaneo Brothers~~ **WISSAKIN**

Service No.

Address 7 Carley Road

Lexington, Mass.

Location 7 Carley Road

Kind of Pipe

Size

Size of **Main**

Repair—Renewal—New Service

Com. 8-16-48 PERMIT NO. 0966 - ARLEX OIL Location

Date	Material	Amount	Total	Date	Amount
June 18, '48	Labor	11 50	11 50		
	10% Overhead		1 15	Oct 13 '48	
	15' - 6" Sewer Pipe @.26		3 90		62 85
	Joint Compound		96		
	Trucking 1 hr. @.75		75	Sewer from house to curb	
			18 26	April 20, '48 Labor	11 93
			34 59	10% Overhead	1 19
			52 85	46' - 6" Sewer Pipe @.26	11 96
				Joint Compound	2 76
				Town shovel 1 hr. @3.00	3 00
				Allis-Chalmers 1 hr. @ 3.00	3 00
				Trucking 1 hr. @.75	75
MAY 27, 1997	40' - 6" PVC				34 59
	22° ELBOW				
	4"X6" FERNCO				
	6"X6" FERNCO				

TOWN OF LEXINGTON—DEPT. OF PUBLIC WORKS

SEWER DIVISION

DATE

NO.


The undersigned applies for the construction of a particular sewer connecting No.
 Street and hereby agrees to comply with the Rules and Regulations governing the construction and use of Particular
 Sewers, as now or at any future time established by the Board of Selectmen.

Am't of estimate \$

Am't Paid \$

..... Owner

Sketch of Service Here **7**

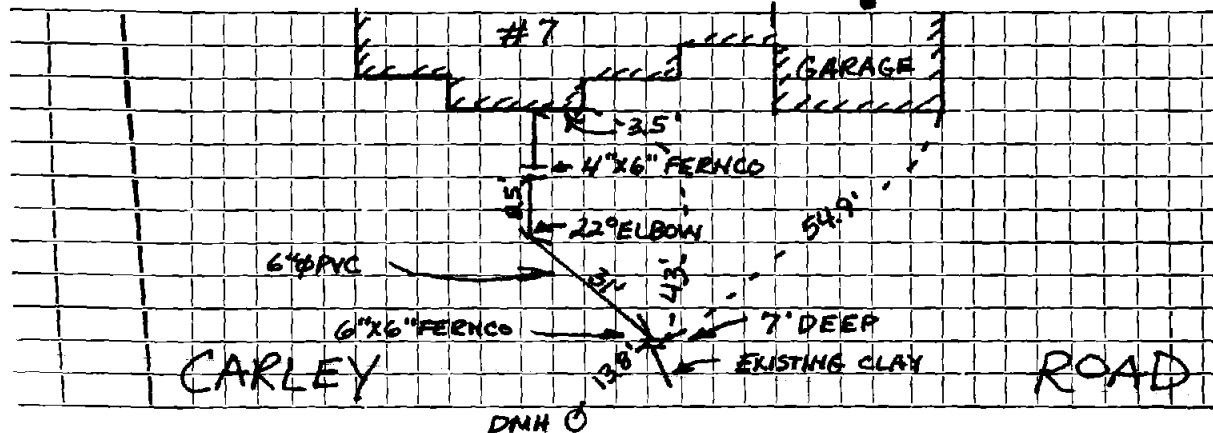

Connection made in CARLEY ROAD Street.

Work completed 19..

Remarks:

BOOK 97-2

J.W.