


DATE 8/12/2019

TOWN OF LEXINGTON — BOARD OF PUBLIC WORKS
SEWER DIVISION

Sketch of Service Here

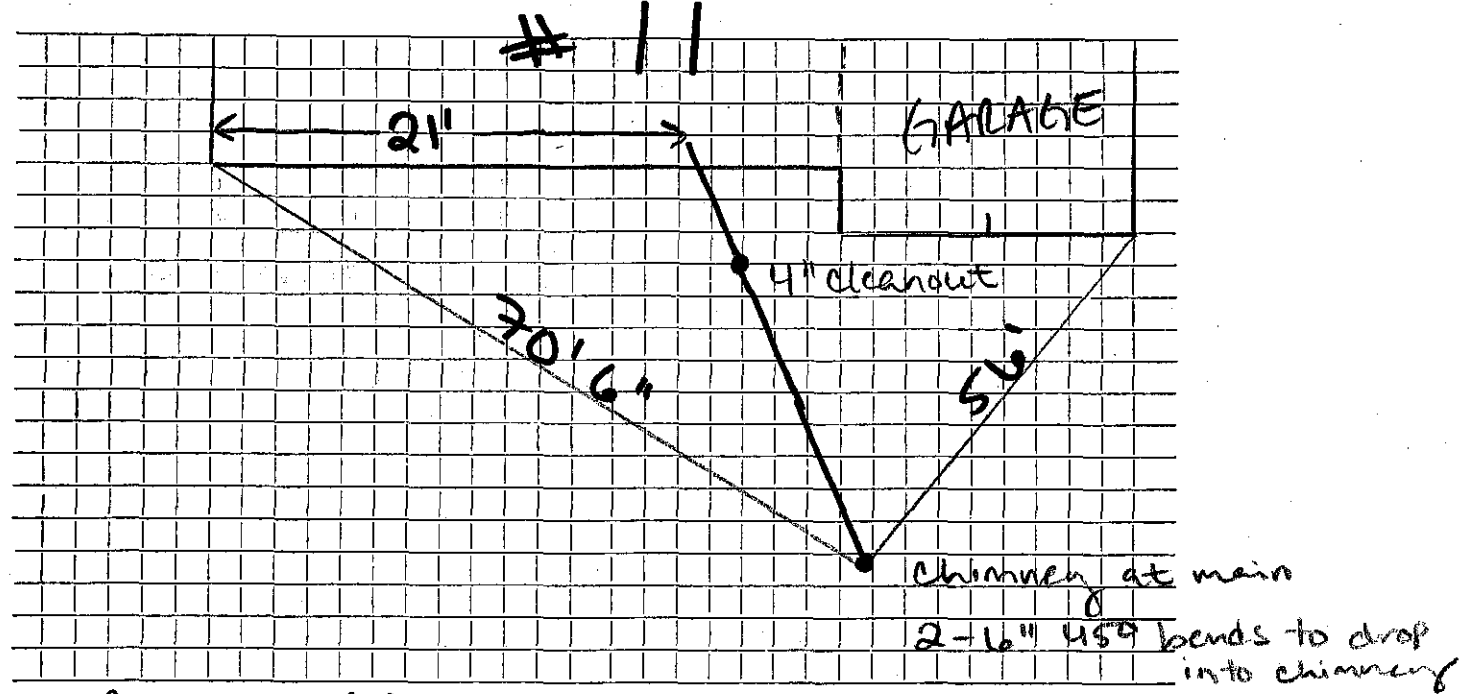

Connection made in Carkey Rd Street. Work completed

Remarks: 4" cleanout right @ corner of garage.
sewer run = 63'