

Name

Service No.

Address

7 CARLE7

Location

Kind of Pipe

SDR35

Size

6"

Size of Main

Repair—~~Renewal~~—New Service

Location

Date

Material

Amount

Total

Date

Amount

7/2/12

- 6' SDR


- 6' x 6" FURCO

1

DATE 4/20/17

TOWN OF LEXINGTON — BOARD OF PUBLIC WORKS
SEWER DIVISION

Sketch of Service Here

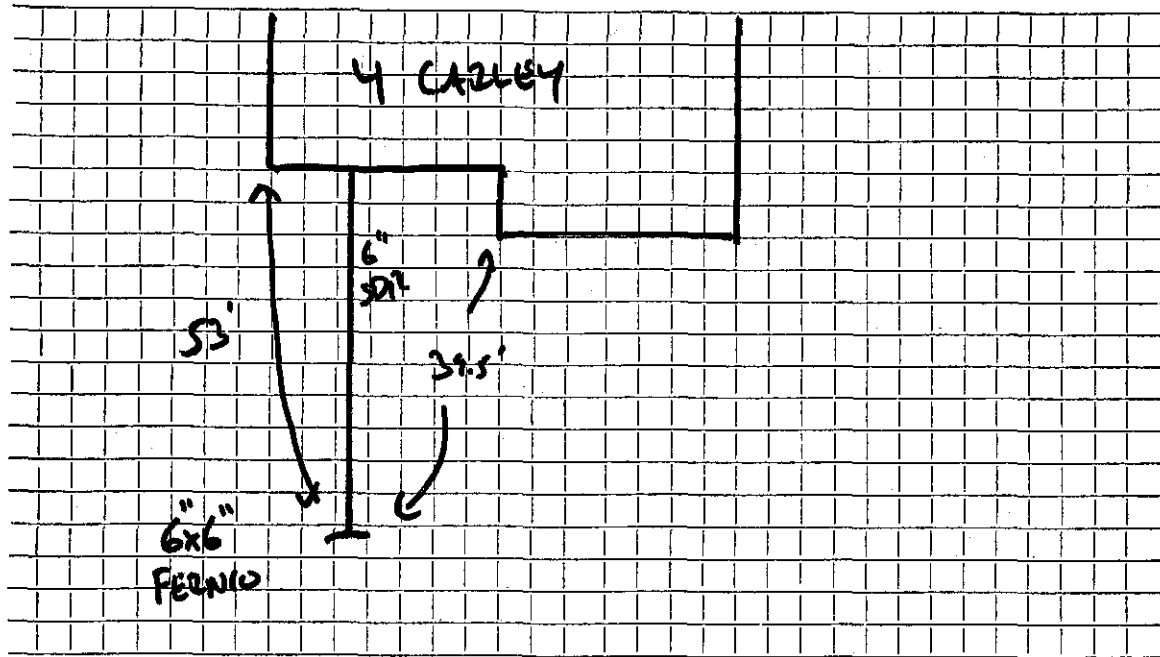

Connection made in CARLEY Street. Work completed McLAUGHLIN

Remarks:

.....

.....