

Name

Service No.

Address 4 Carmel Circle

Lot 1

Location

Kind of Pipe

Size

Size of Main

Repair—Renewal—New Service Lucente #1329

Location

Date

Material

Amount

Total

Date

Amount

~~5-2-69 25' 6" Transite pipe~~

5-2-69


25' 6" Transite

DATE _____

TOWN OF LEXINGTON — BOARD OF PUBLIC WORKS

SEWER DIVISION

Sketch of Service Here **4**

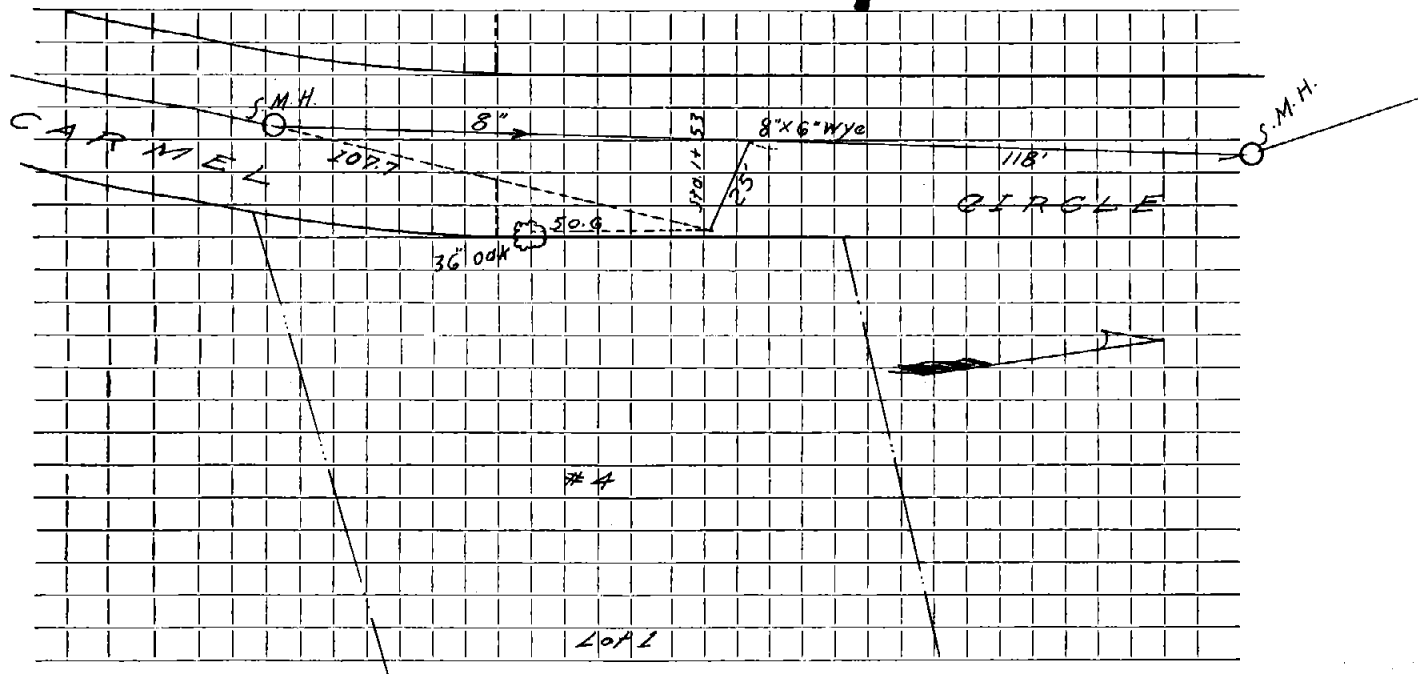

Connection made in Street. Work completed

Remarks:
.....
.....