




DATE \_\_\_\_\_

# TOWN OF LEXINGTON — BOARD OF PUBLIC WORKS

## SEWER DIVISION

Sketch of Service Here **7**

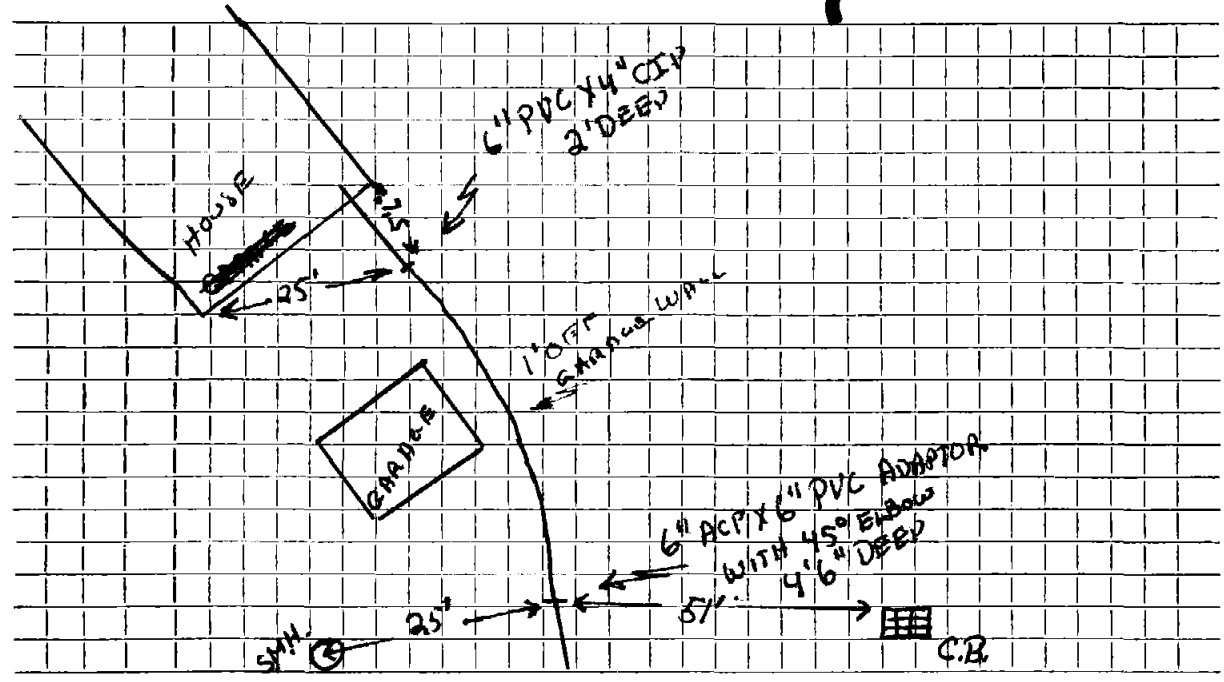

Connection made in \_\_\_\_\_ Street. Work completed \_\_\_\_\_

Remarks: WATER SERVICE UNDER SEWER, BESIDE GARAGE, 3' OFF FOUNDATION.