

Name John Repetto

Service No. 67

Address 3 Carnegie Place

Location

Kind of Pipe

Size

Size of Main

~~Repair~~ ~~Renewal~~ New Service W.O. #5707

Location

DEC 12 1977


Date	Material	Amount	Total	Date	Amount
9/15/77	Labor	92 56		8-12-77	280 00
	10% O.H.	9 25	101 81	12-12-77	2 57
	20' 6' Transite @ 1.75		35 00	1-17-78	27 96
	1 30° Bend		9 80		
	1 6"x8" Saddle		20 42		
	2 Ton Cold Patch @ 13.25		26 50		
	2 Hrs. Town Shovel @ 6.50		13 00		
	1 Hr. Trucking		3 00		
	Hot Top 6'x27'		108.00		
			317 53		
9/16/77	54' - 6" ACP; 15' - 4" CI				

Deposit  
 Paid by W.H. #54  
 Paid

DATE \_\_\_\_\_

TOWN OF LEXINGTON — BOARD OF PUBLIC WORKS  
SEWER DIVISION

Sketch of Service Here **3**

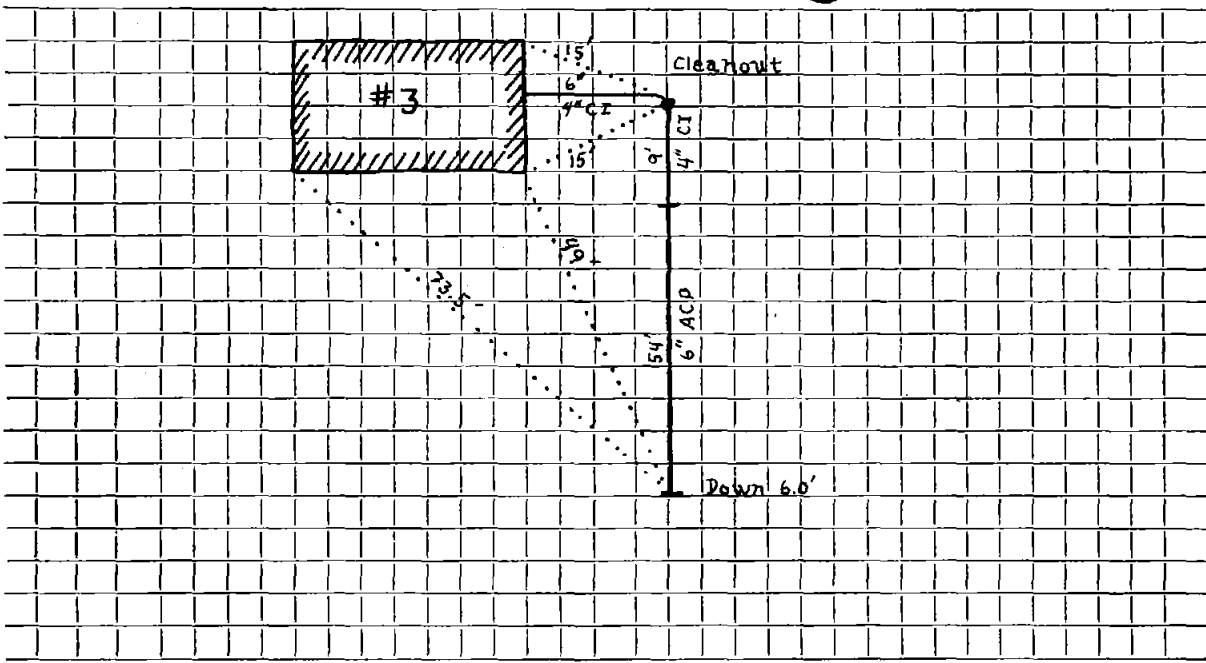

Connection made in ..... Street. Work completed .....

Remarks: .....  
.....  
.....