

Name John Lundquist
Todd Reality Trust

Service No.

Address 10 Carol Lane

Lot # 5

Location

Kind of Pipe

Size

Size of Main

Repair—Renewal—New Service

Eagle #1375
Lucente #996

Location

Date

Material

Amount

Total

Date

Amount

~~1968~~ 35' 6" Transite Pipe

6-11-69 43' 6" Transite pipe

10' 4" Copper tubing

1968

35' 6" Transite


1 6" X 8" Wye

DATE _____

TOWN OF LEXINGTON — BOARD OF PUBLIC WORKS

SEWER DIVISION

Sketch of Service Here **10**

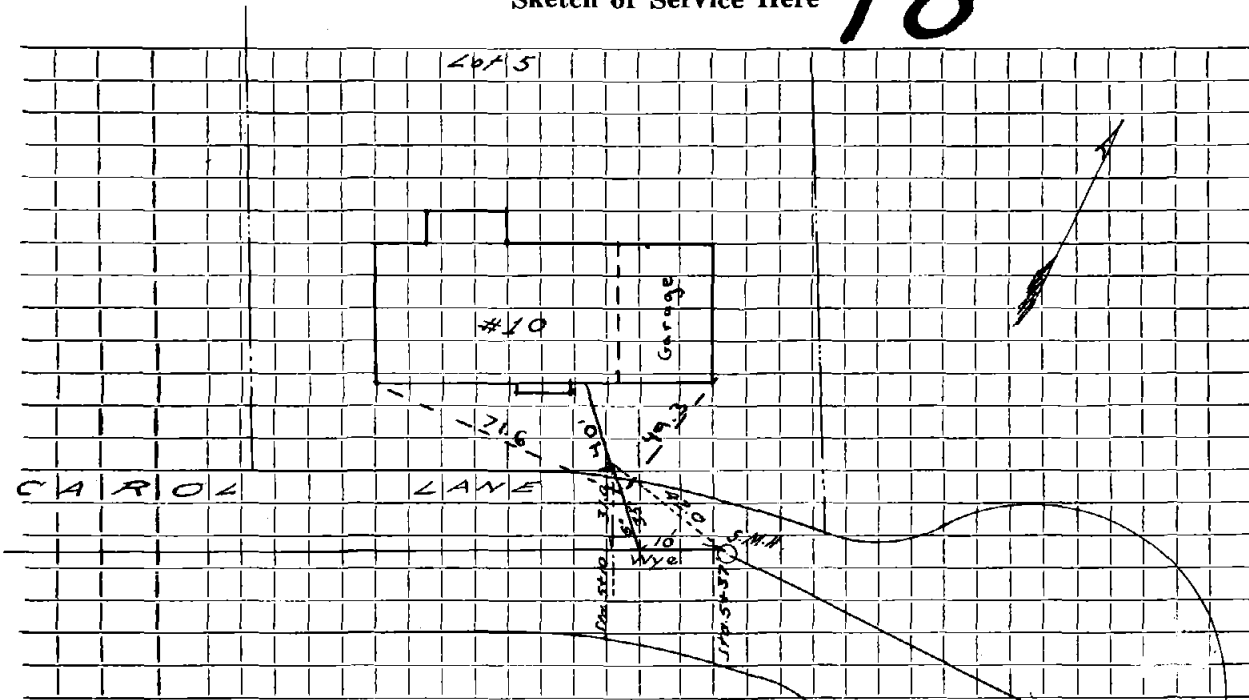

Connection made in Street. Work completed S.M.H.

Remarks:
.....
.....