

Name Mark Moore

Service No.

Address 12 Carol Lane

Location

Kind of Pipe

Size

Size of Main

Repair—Renewal—New Service

DeFlice Bros. - #1033

Location

Date

Material

Amount

Total

Date

Amount

6-11-68 57' 6" Transite
10' 4" Cast Iron


1968

70' 6" Transite
1 6" X 8" Wye

DATE _____

TOWN OF LEXINGTON — BOARD OF PUBLIC WORKS
SEWER DIVISION

Sketch of Service Here **12**

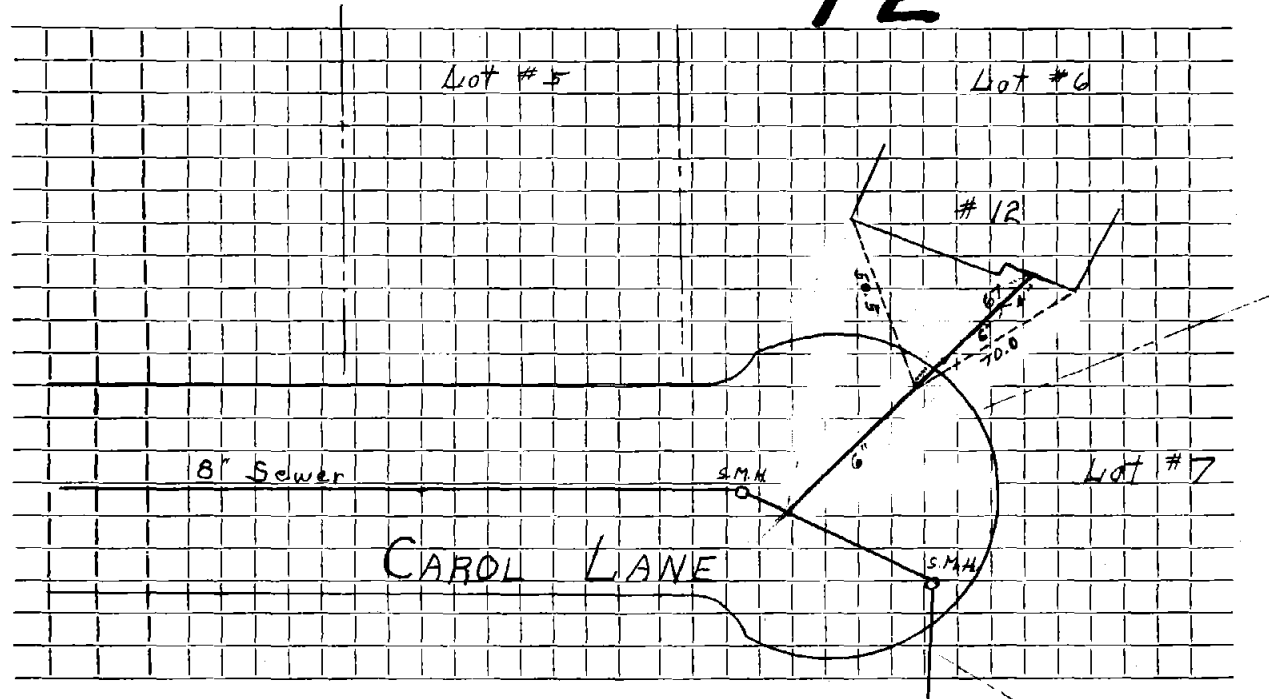

Connection made in Street. Work completed

Remarks:
.....
.....