

Name Todd Reality Trust

Service No.

Address 3 Carol Lane

Lot 12

Location

Kind of Pipe

Size

Size of Main

Repair—Renewal—New Service

DeFelice #2404
Lucente #1103

Location


Date		Material	Amount		Total		Date		Amount
1968	33'	6" Transite Pipe							
10/11/73	33'	6" Transite pipe							
	10'	4" Cast Iron pipe					1968		
							33' 6" Transite		
							1 6" X 8" Wye		

DATE _____

TOWN OF LEXINGTON — BOARD OF PUBLIC WORKS

SEWER DIVISION

Sketch of Service Here **3**

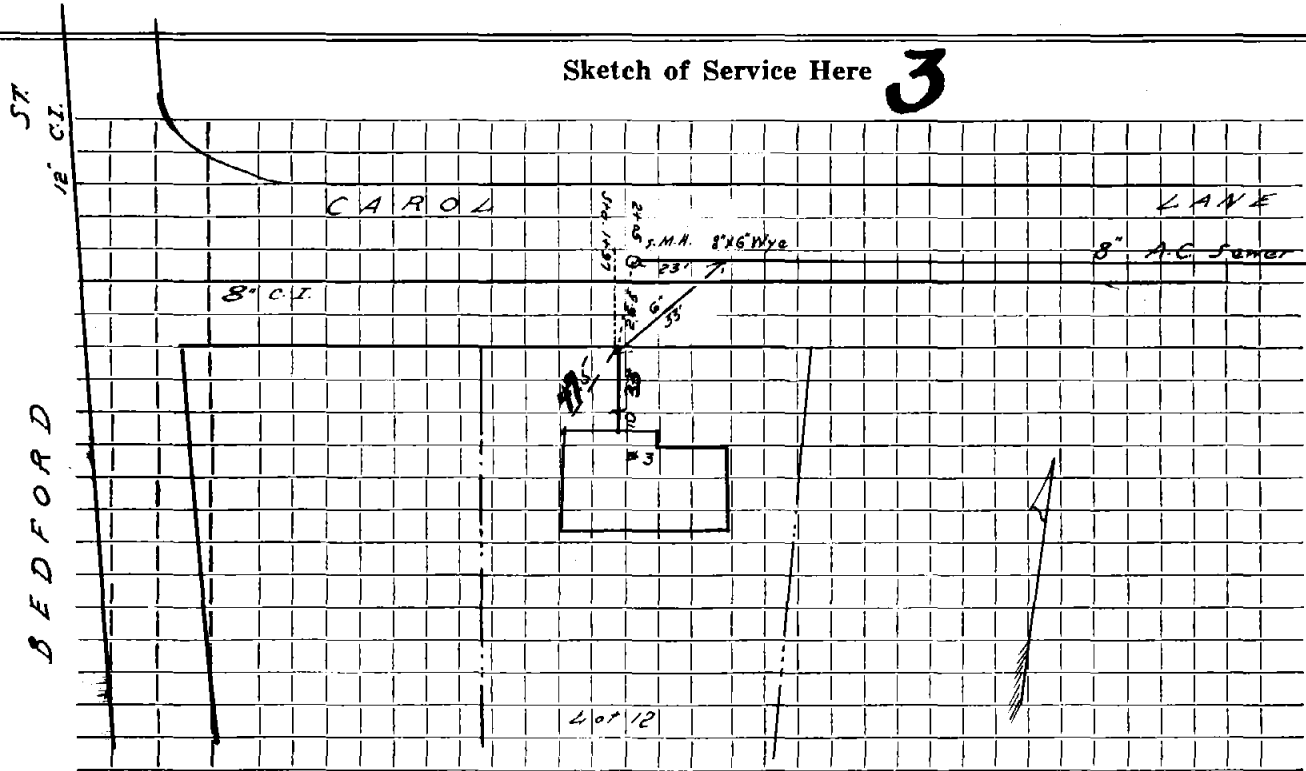

Connection made in Street. Work completed

Remarks:
.....
.....