

Name Todd Reality Trust

Service No.

Address 4 Carol Lane

Lot # 2

Location

Kind of Pipe

Size

Size of Main

Repair—Renewal—New Service

Lucente #993

Location


Date	Material	Amount	Total	Date	Amount
<del>1968</del>	<del>35' 6" Transite Pipe</del>				
10/22/68	114' 6" Transite Pipe				
	10' 4" Cast Iron			1968	
				35' 6" Transite	

DATE \_\_\_\_\_

TOWN OF LEXINGTON — BOARD OF PUBLIC WORKS  
SEWER DIVISION

Sketch of Service Here

4

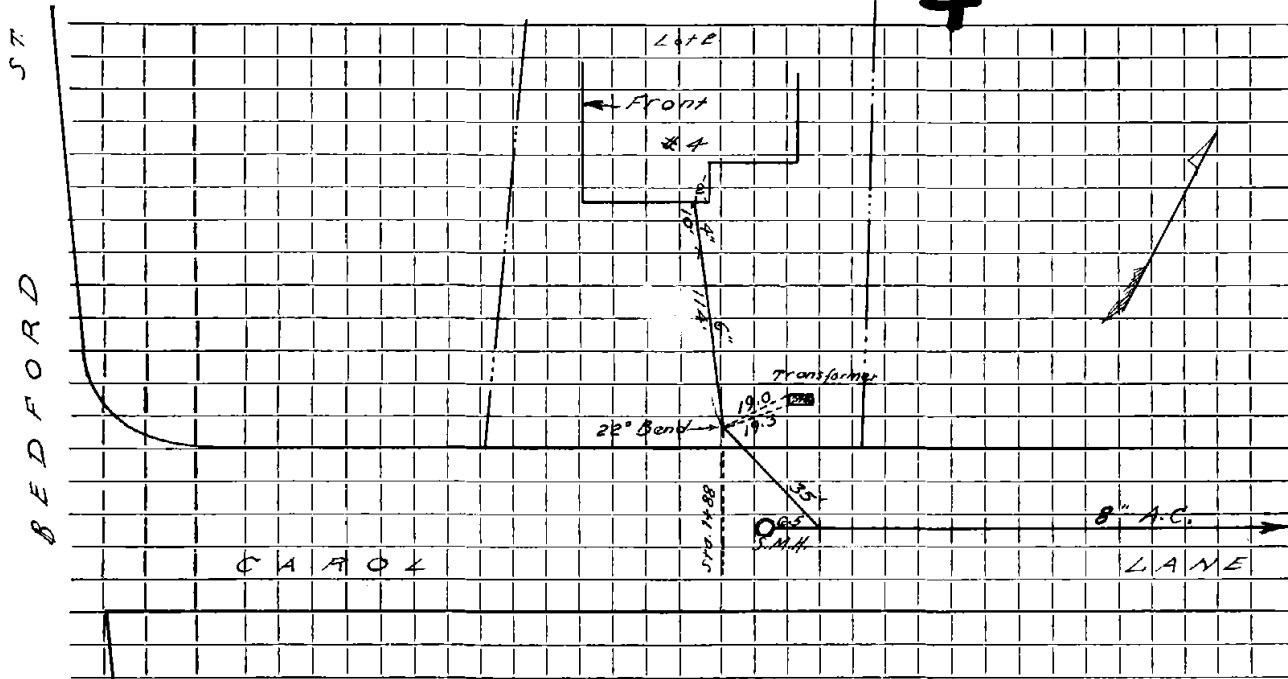

Connection made in \_\_\_\_\_ Street. Work completed \_\_\_\_\_

Remarks: \_\_\_\_\_  
\_\_\_\_\_  
\_\_\_\_\_