




DATE \_\_\_\_\_

TOWN OF LEXINGTON — BOARD OF PUBLIC WORKS  
SEWER DIVISION

Sketch of Service Here

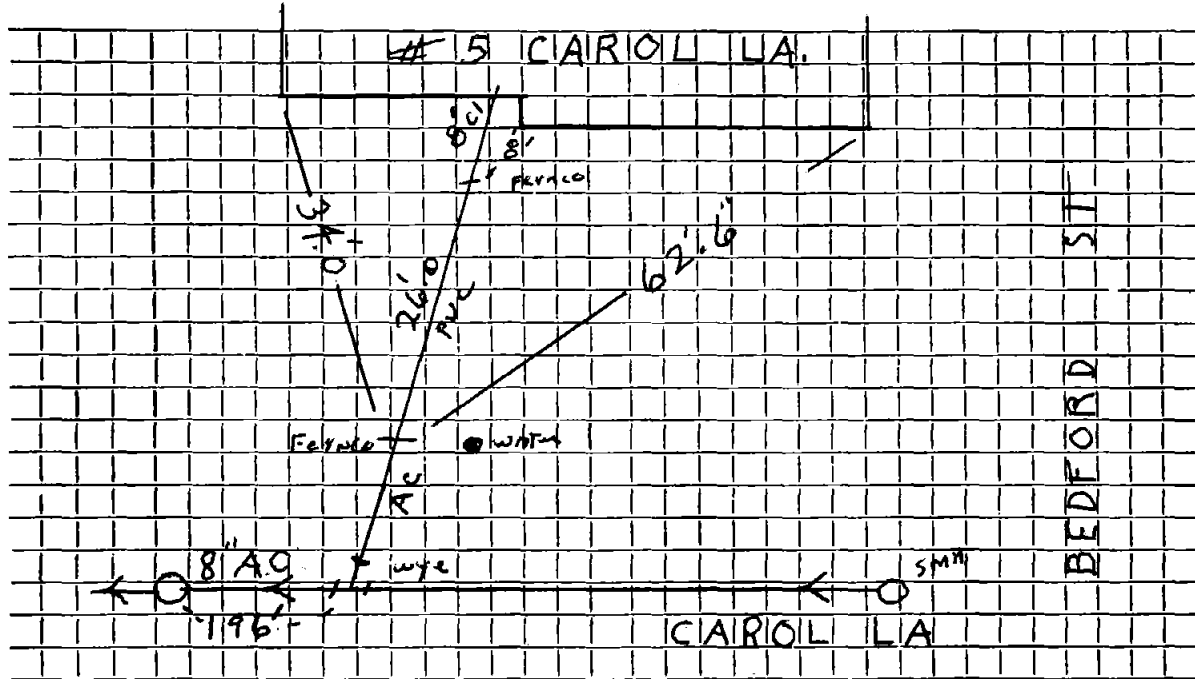

Connection made in \_\_\_\_\_ Street. Work completed 9/26/06 B. McKee

Remarks: WATER IS IN SAME TRENCH WITH SEWER. SEWER 6' DOWN, WATER 5' DOWN

CAST IRON PIPE DOWN 7' 6"