

Name

Service No.

Address

10 Carriage Dr

Location

Kind of Pipe

SDR Sch. 35 PVC

Size

6"

Size of Main

Repair

~~Renewal~~

New Service

Location

Date

Material

Amount

Total

Date

Amount

2/18/21

4" Sch. 40 PVC

4" x 6" FernCo

6" Cleanout

6" SDR Sch. 35 70'


6" FernCo AC to PVC

DATE 2/18/2021

TOWN OF LEXINGTON — BOARD OF PUBLIC WORKS

SEWER DIVISION

Sketch of Service Here

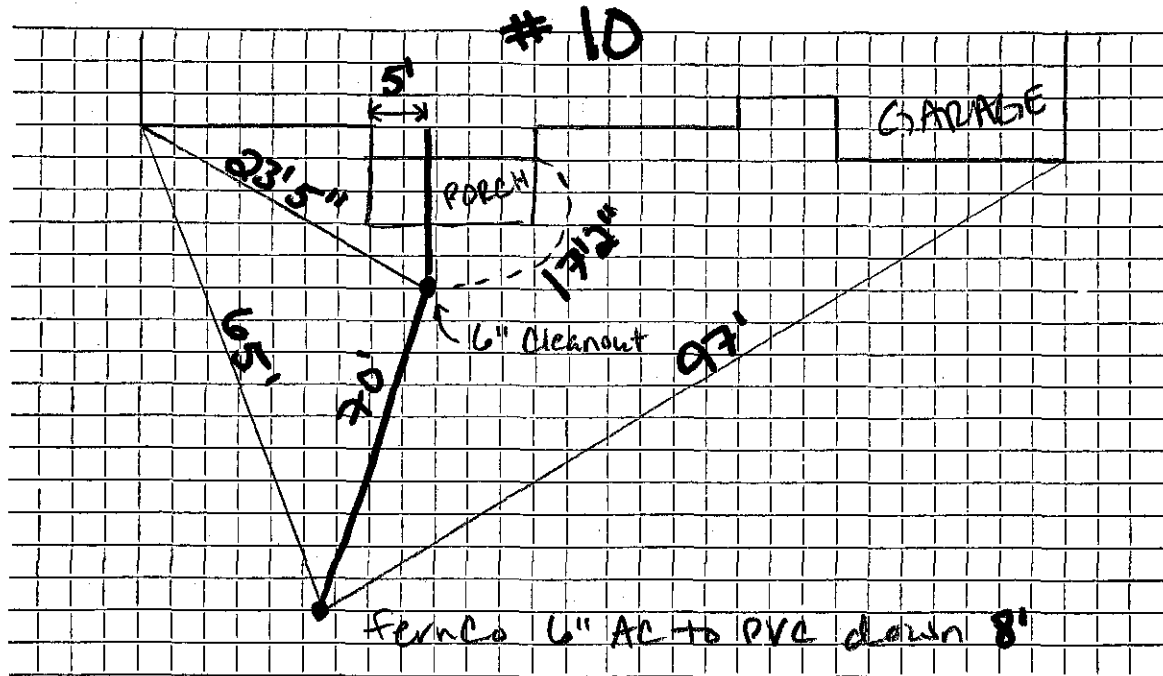

Connection made in Carriage Drive Street. Work completed .....

Remarks: .....

.....

.....