




DATE \_\_\_\_\_

TOWN OF LEXINGTON — BOARD OF PUBLIC WORKS  
SEWER DIVISION

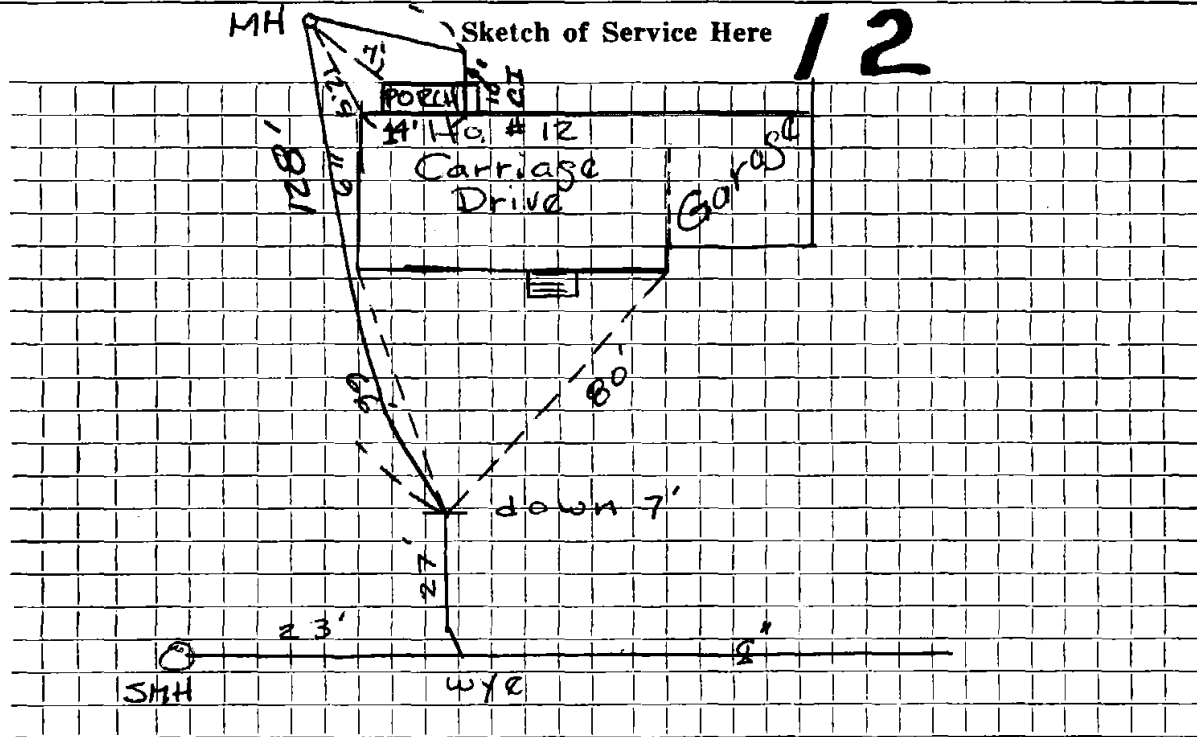

Connection made in Carriage Dr. Street.

Work completed DECEMBER 15, 1975

Remarks: .....

.....

.....