




DATE \_\_\_\_\_

TOWN OF LEXINGTON — BOARD OF PUBLIC WORKS  
SEWER DIVISION

Sketch of Service Here

15

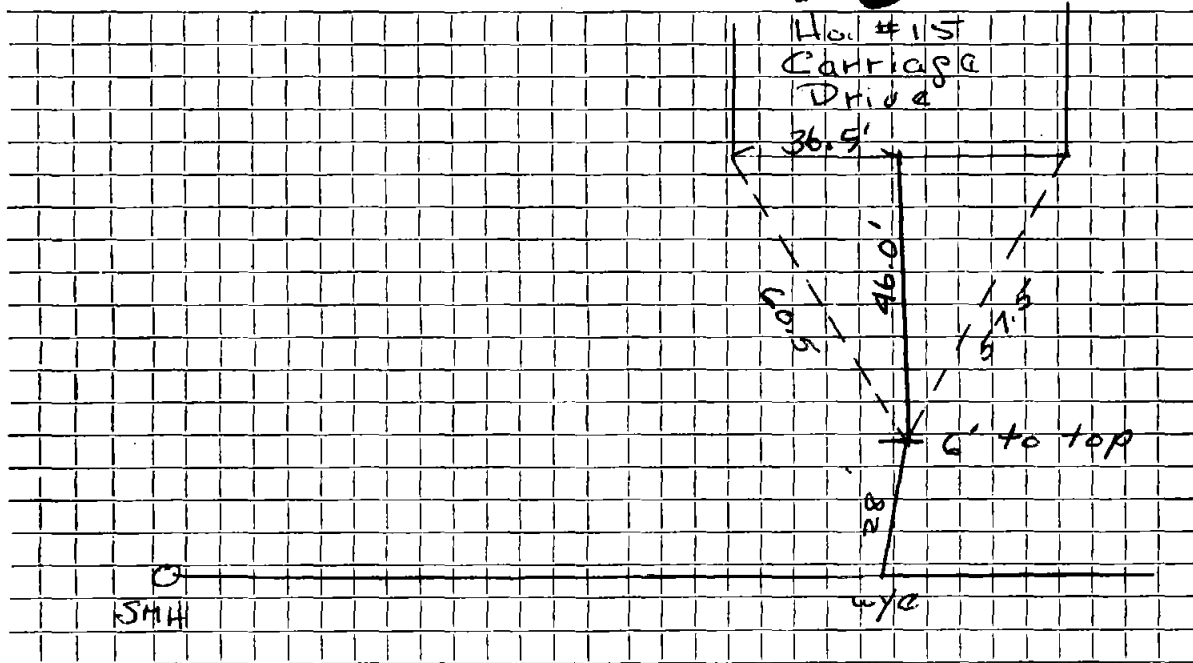

Connection made in Carriage Dr. Street. Work completed 12-8-75

Remarks: .....

.....

.....