

Name David Korff

Service No. 25

Address 17 Carriage Dr.

Location

JUL 24 1978

Kind of Pipe AC

Size 6"

Size of Main 8"

~~REPAIR~~ ~~RENEWAL~~ New Service Valeri #3332

Location

Date	Material	Amount	Total	Date	Amount
------	----------	--------	-------	------	--------

7-9-75	31'-6" AC @	\$ 10.00 =	\$ 310.00	4-12-78	310.00
-------------------	------------------------	-----------------------	----------------------	--------------------	-------------------

6/13/78	95'-6" ACP ; 9'-4" CI				
---------	-----------------------	--	--	--	--

				7-9-75	
				31' 6" A. C.	


Deposit

310.00

DATE _____

TOWN OF LEXINGTON — BOARD OF PUBLIC WORKS

SEWER DIVISION

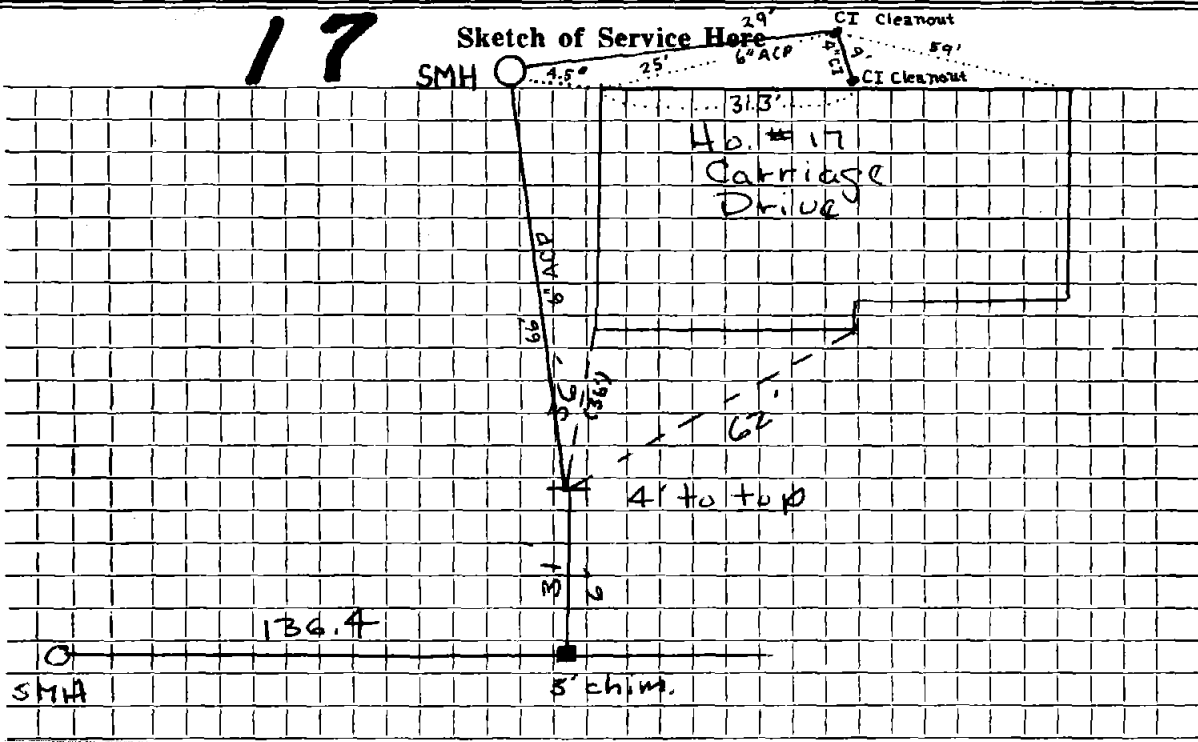

Connection made in Carriage Dr. Street. Work completed

Remarks:

.....

.....