

Name Carlson Miller

Service No. 167 (71)

Address 19 Carriage Dr.

Location

Kind of Pipe AC

Size 6"

Size of Main 8"

Repair—Renewal—New Service

Valeri #2937


Location AUG 16 1976

Date		Material	Amount	Total	Date	Amount	
7-9-75		31' 6" AC @	10.00 =	310.00	12/15/75	Deposit	310.00
12/17/75	84.5'	6" Transite Pipe					
	9'	4" Cast Iron Pipe			7-9-75		
					31' 6" A.C.		

DATE _____

TOWN OF LEXINGTON — BOARD OF PUBLIC WORKS

SEWER DIVISION

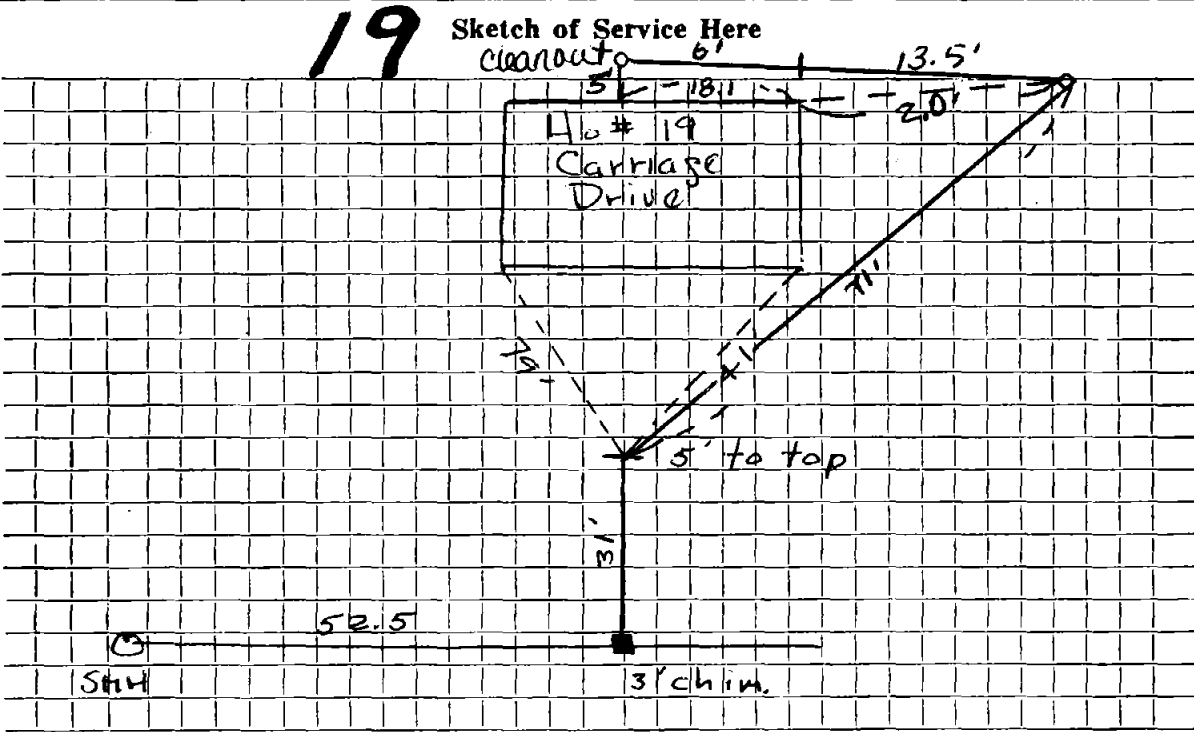

Connection made in Carriage Dr. Street. Work completed 12-17-75

Remarks: