


DATE _____

TOWN OF LEXINGTON — BOARD OF PUBLIC WORKS

SEWER DIVISION

Sketch of Service Here **20**

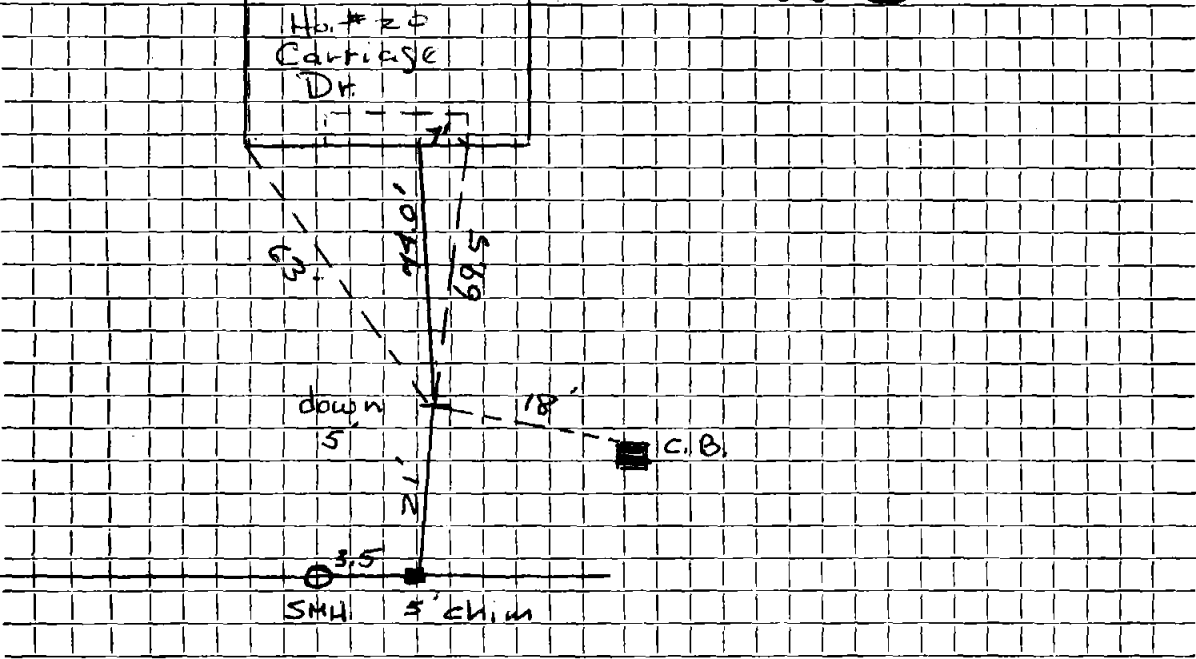

Connection made in Carriage Dr. Street. Work completed 19-23-75

Remarks:
.....
.....