

Name

Service No.

Address 21 Carriage Dr.

Location

Kind of Pipe AC

Size 6"

Size of Main 8"

Repair—Renewal—New Service

Location

Date

Material

Amount

Total

Date

Amount

~~7-3-75~~ 28'-6" AC @ \$10.00 = \$280.00

7-3-75

28' 6" A.C.


1 6" X 8" Wye

DATE _____

TOWN OF LEXINGTON — BOARD OF PUBLIC WORKS
SEWER DIVISION

Sketch of Service Here

21

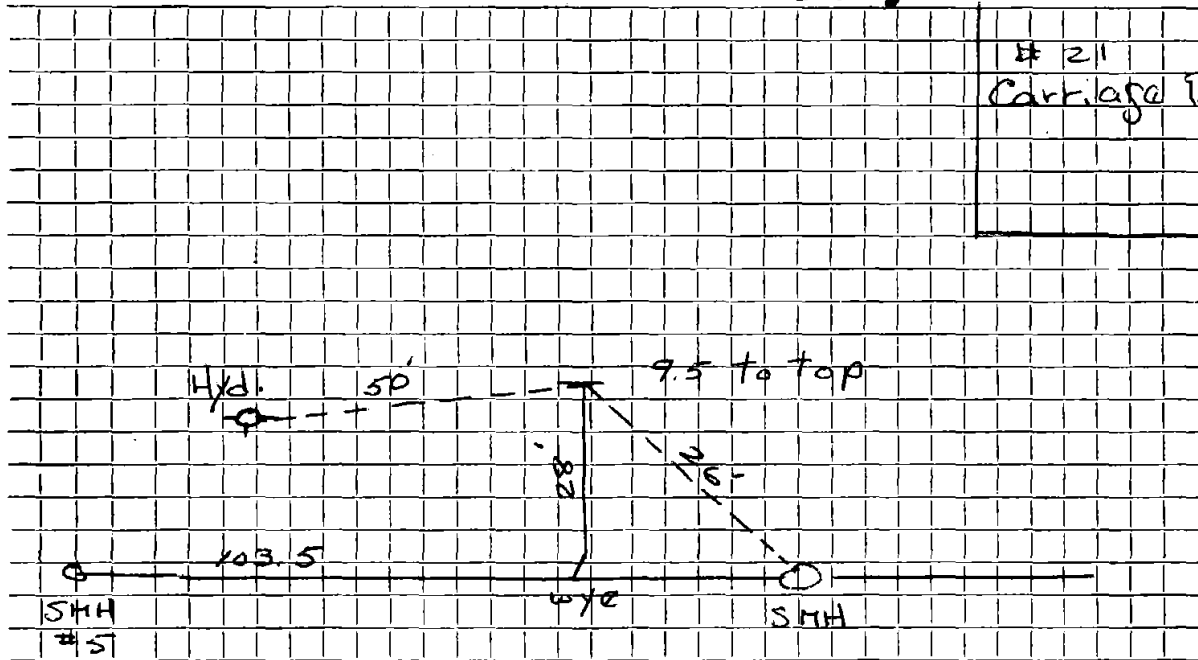

21
Carriage Dr.

Connection made in Carriage Dr Street. Work completed

Remarks:
.....
.....