


DATE _____

TOWN OF LEXINGTON — BOARD OF PUBLIC WORKS
SEWER DIVISION

Sketch of Service Here **27**

LOT #8

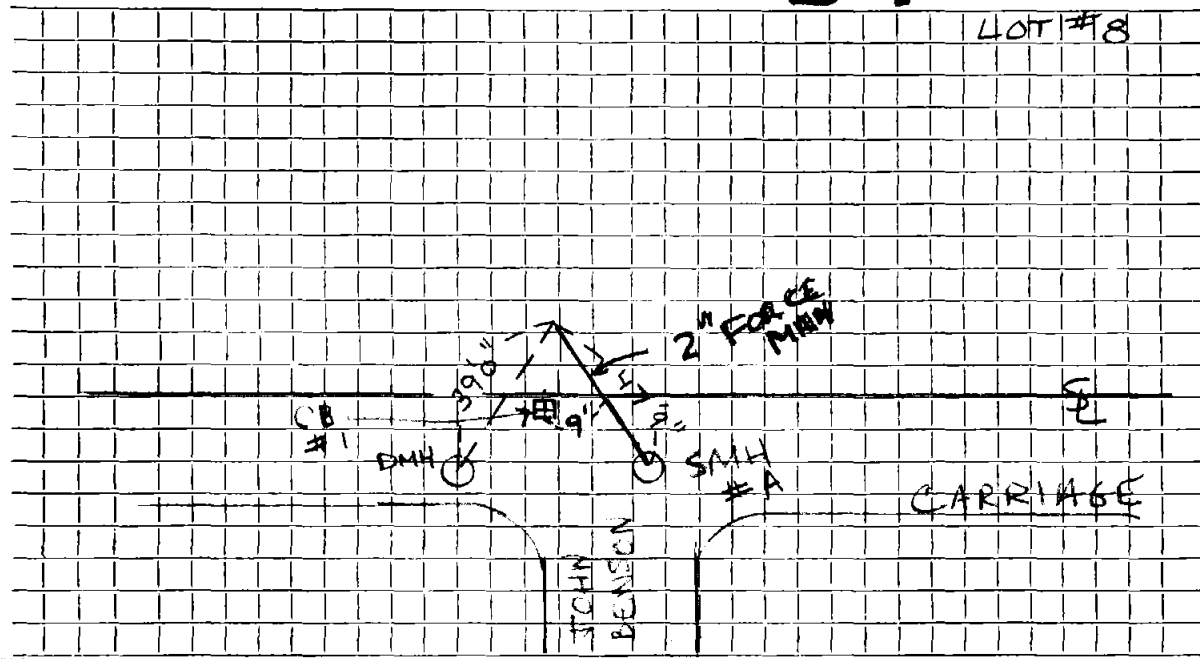

Connection made in Street. Work completed


Remarks:
.....
.....

DATE '91

TOWN OF LEXINGTON — BOARD OF PUBLIC WORKS
SEWER DIVISION

#27 CARRIAGE DRIVE

Sketch of Service Here **27**

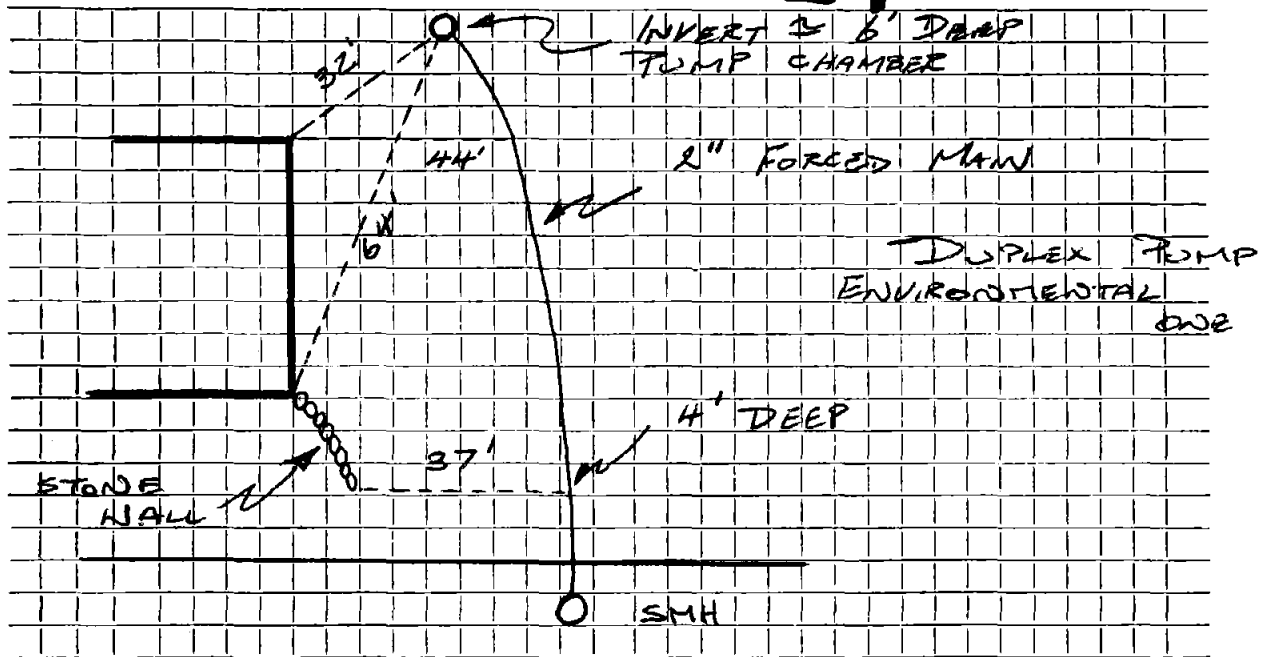

Connection made in #27 CARRIAGE DRIVE ~~Street~~. Work completed

Remarks: