


DATE _____

TOWN OF LEXINGTON — BOARD OF PUBLIC WORKS

SEWER DIVISION

Sketch of Service Here **29**

LOT # 9

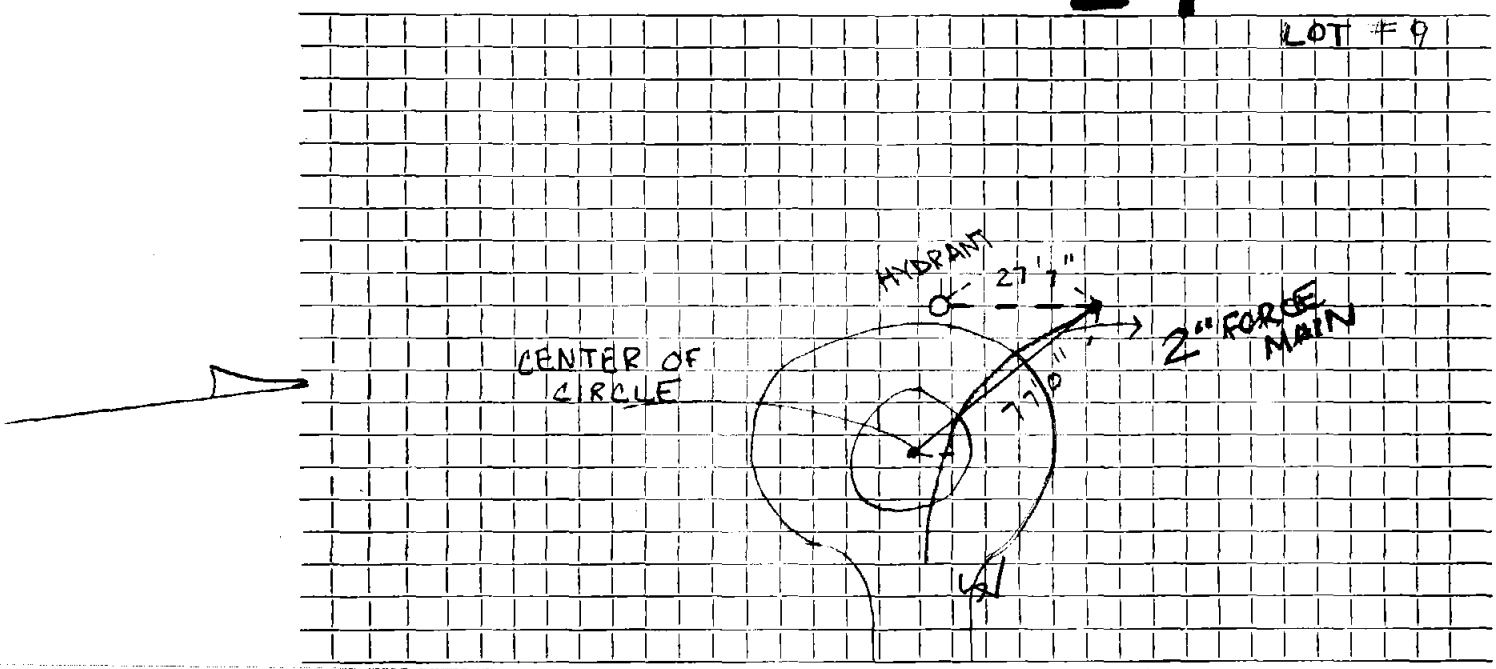

Connection made in Street. Work completed

Remarks:
.....
.....