

Name Jeff Hodgdon

Service No.

Address 3 CARRIAGE RD.

Location

Kind of Pipe

Size

Size of Main

Repair—Renewal—New Service Arlex ,Oil #0410

Location

Date	Material	Amount	Total	Date	Amount
------	----------	--------	-------	------	--------

11/21/99	167 LF 6" PVC				
----------	---------------	--	--	--	--

	3 92° ELBOW				
--	-------------	--	--	--	--

	2 6x6 FRANCO				
--	--------------	--	--	--	--

				7-12-75	
--	--	--	--	---------	--


				30' 6" A.C.	
--	--	--	--	-------------	--

				1 6" X 8" Wye	
--	--	--	--	---------------	--

DATE 11/21/94

TOWN OF LEXINGTON — BOARD OF PUBLIC WORKS
SEWER DIVISION

Sketch of Service Here **3**

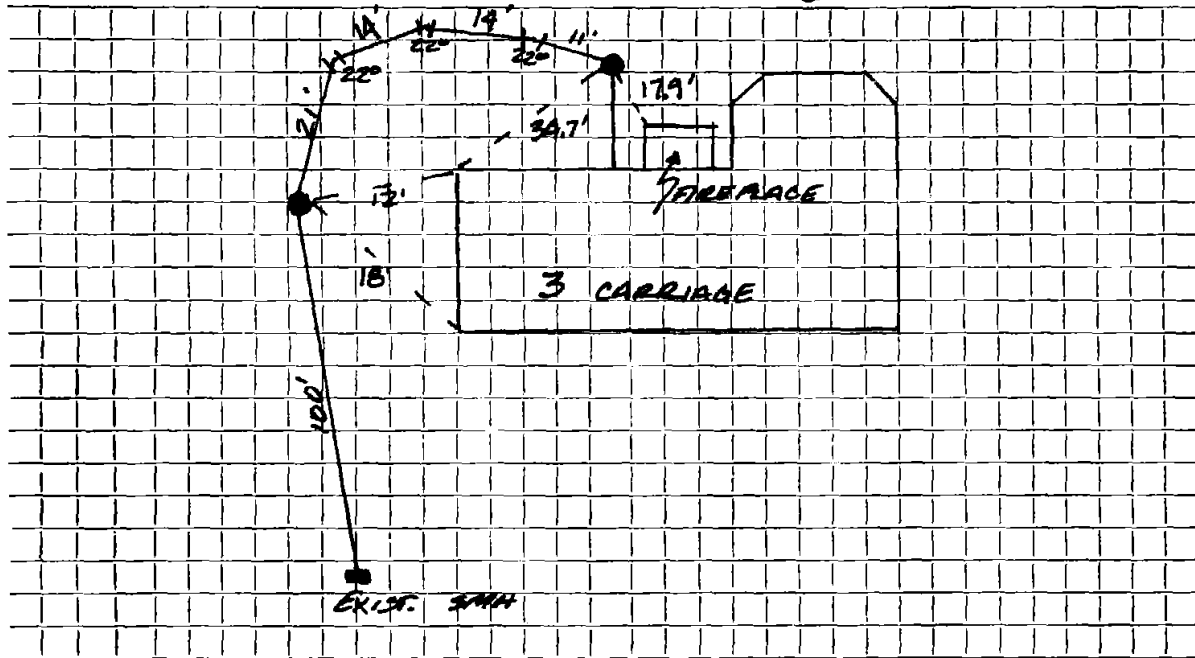

Connection made in CARRIAGE Street. Work completed ... ARLEX

Remarks:
.....
.....