




DATE \_\_\_\_\_

TOWN OF LEXINGTON — BOARD OF PUBLIC WORKS  
SEWER DIVISION

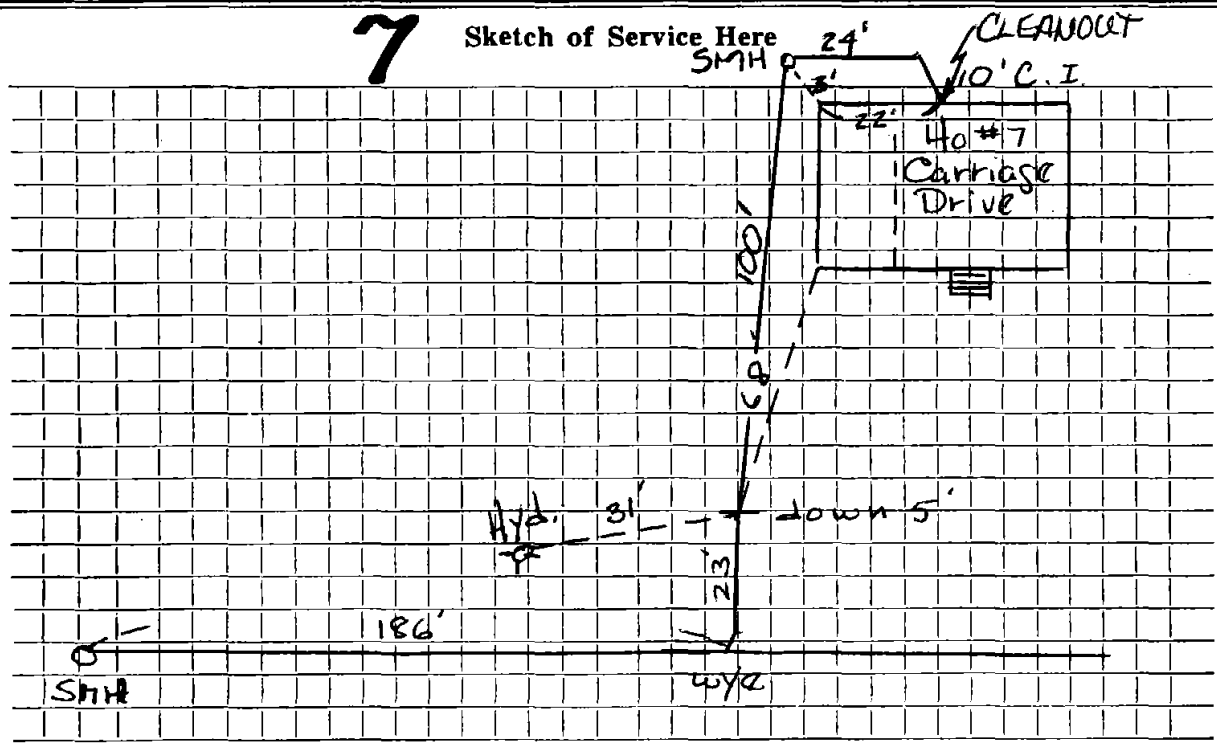

Connection made in Carriage Dr Street. Work completed 3-5-16

Remarks: .....

.....

.....