

Name Allen F. Patzinger

Service No. 16

Address 8 Carriage Drive

Location

Kind of Pipe AC

Size 6"

Size of Main 8"

8"

~~RENEWAL~~ New Service Valeri #3970

Location


JUN 23 1980

Date	Material	Amount	Total	Date	Amount
7-10-75	26' 6" AC @	10.00 =	260.00	5-9-80	Deposit
5/16/80	152' 6" Transite pipe				260.00
	10' 4" Cast Iron pipe			7-10-75	
				26' 6" A.C.	
				1 6" X 8" Wye	

DATE _____

TOWN OF LEXINGTON — BOARD OF PUBLIC WORKS

SEWER DIVISION

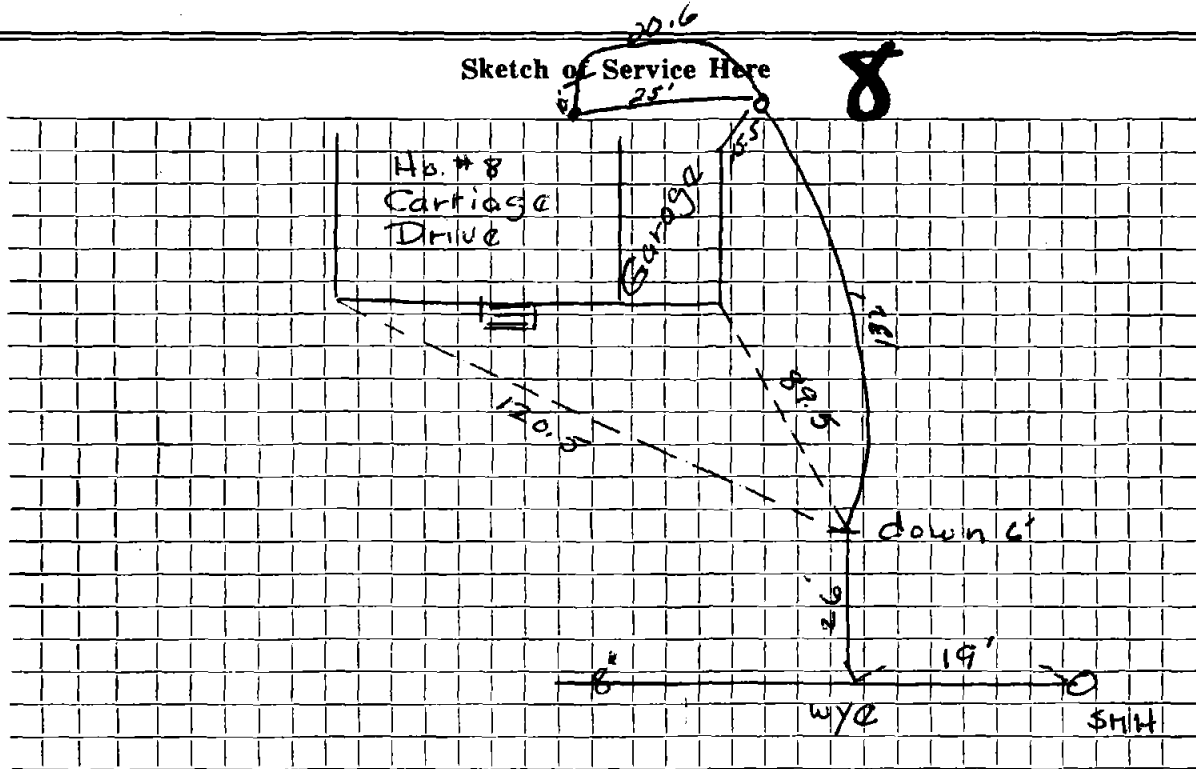

Connection made in Carriage Dr. Street. Work completed

Remarks:

.....

.....