


DATE _____

TOWN OF LEXINGTON — BOARD OF PUBLIC WORKS
SEWER DIVISION

Sketch of Service Here **9**

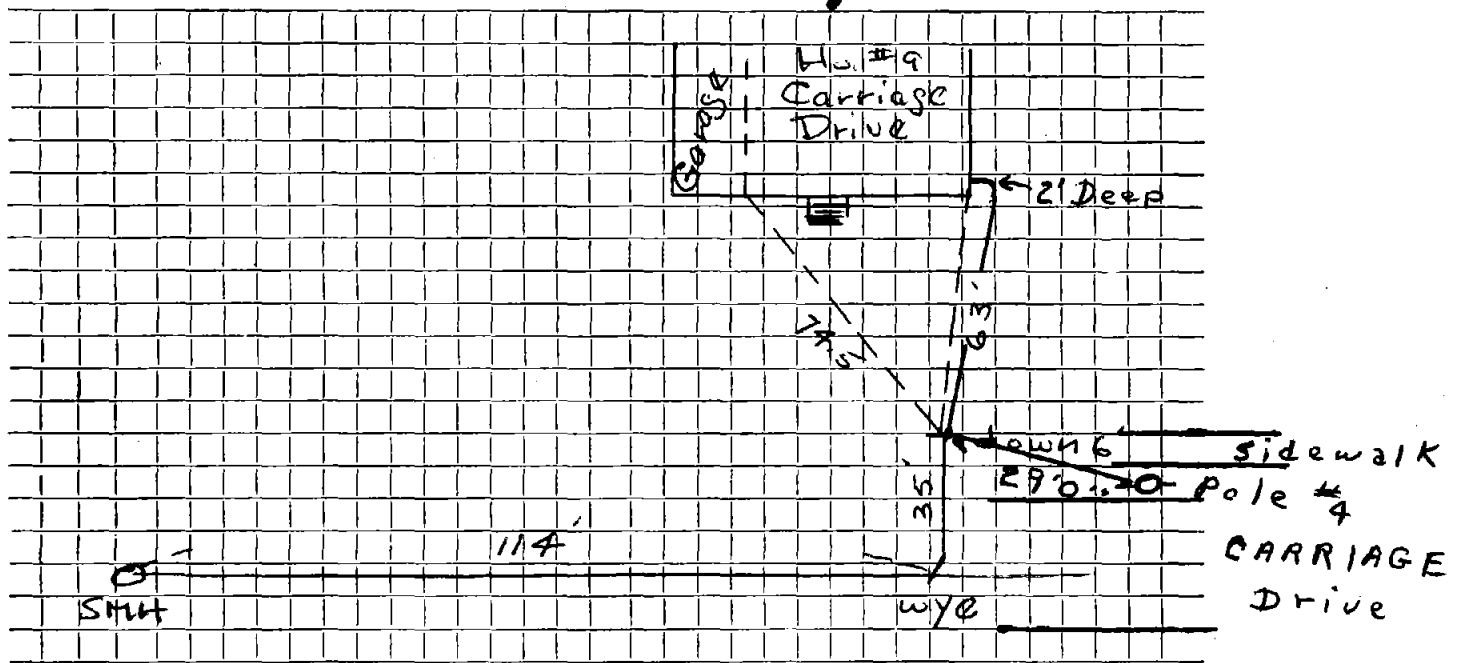

Connection made in Carriage Dr. Street. Work completed

Remarks: 1.- 90° elbow on iron, 1.- Wye and clean out after elbow...
6 7/8" P.U.S. 6" put in by Dave Eagle 10-7-80