


DATE 1/11/19

TOWN OF LEXINGTON — BOARD OF PUBLIC WORKS
SEWER DIVISION

Sketch of Service Here

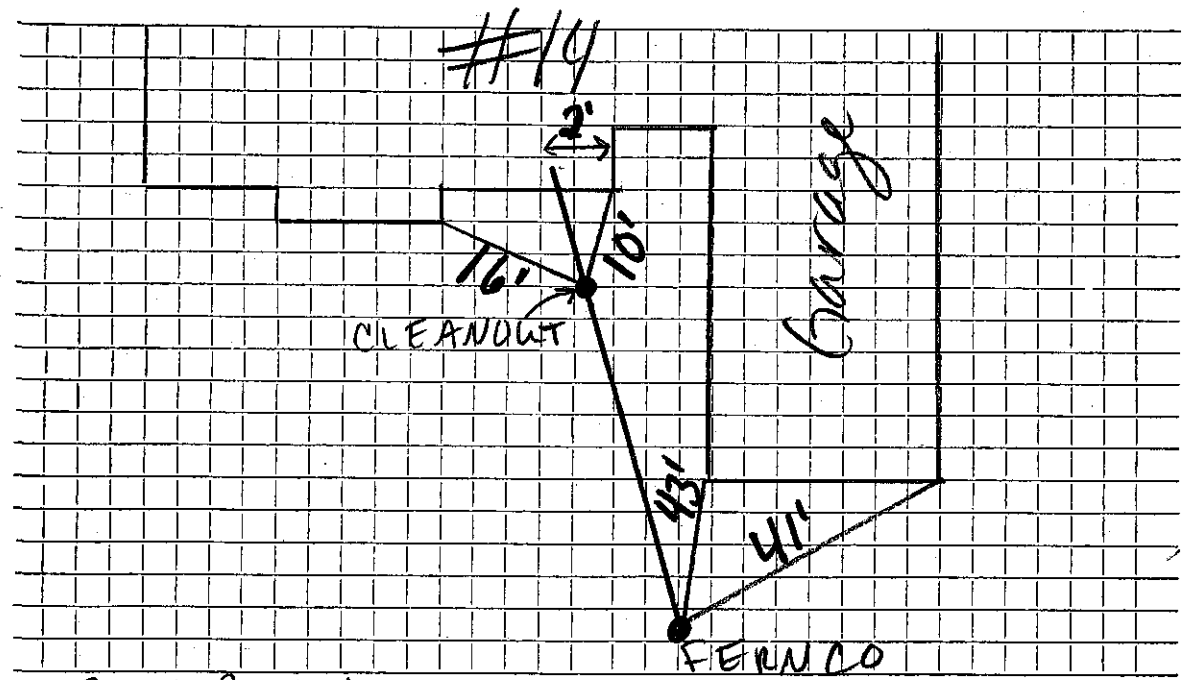

Connection made in ... Cart Path Ln ... Street. Work completed

Remarks:
.....
.....