


DATE 8/29/2018

TOWN OF LEXINGTON — BOARD OF PUBLIC WORKS
SEWER DIVISION

Sketch of Service Here

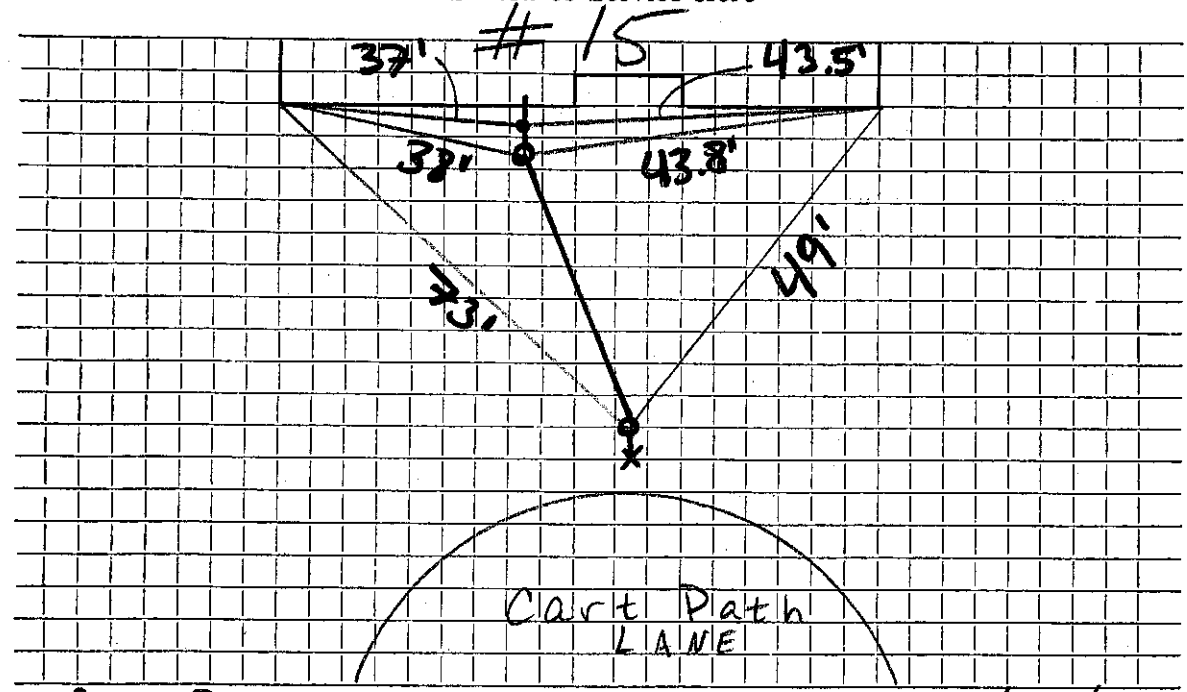

Connection made in ... Cart Path Lane Street. Work completed ... 8/29/2018 10:30 AM
Remarks: ... Connect to existing stub ...
○ = 22° bend
● = cleanout
x = ferro