


DATE 9/5/2018

TOWN OF LEXINGTON — BOARD OF PUBLIC WORKS
SEWER DIVISION

Sketch of Service Here

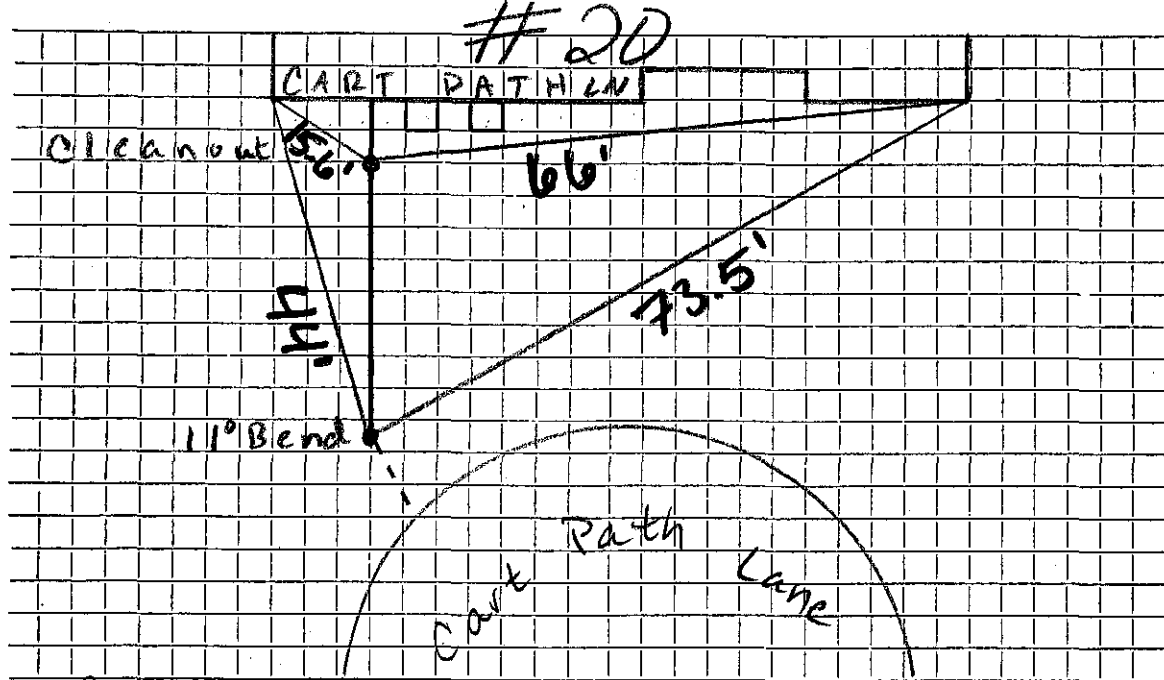

Connection made in CART PATH LN Street. Work completed 9/5/2018

Remarks: Connect to existing stub