

Name

Contractor: Iovino

Service No.

Address

9 Cart Path Ln

Location

Kind of Pipe

SDR 35 PVC

Size

6"

Size of Main

Repair—Renewal—New Service

Location

Date

Material

Amount

Total

Date

Amount

1/9/19

4" Sch. 40 pipe

6" Cleanout


6" PVC pipe

6" Fern Co

DATE 1/9/19

TOWN OF LEXINGTON — BOARD OF PUBLIC WORKS
SEWER DIVISION

Sketch of Service Here

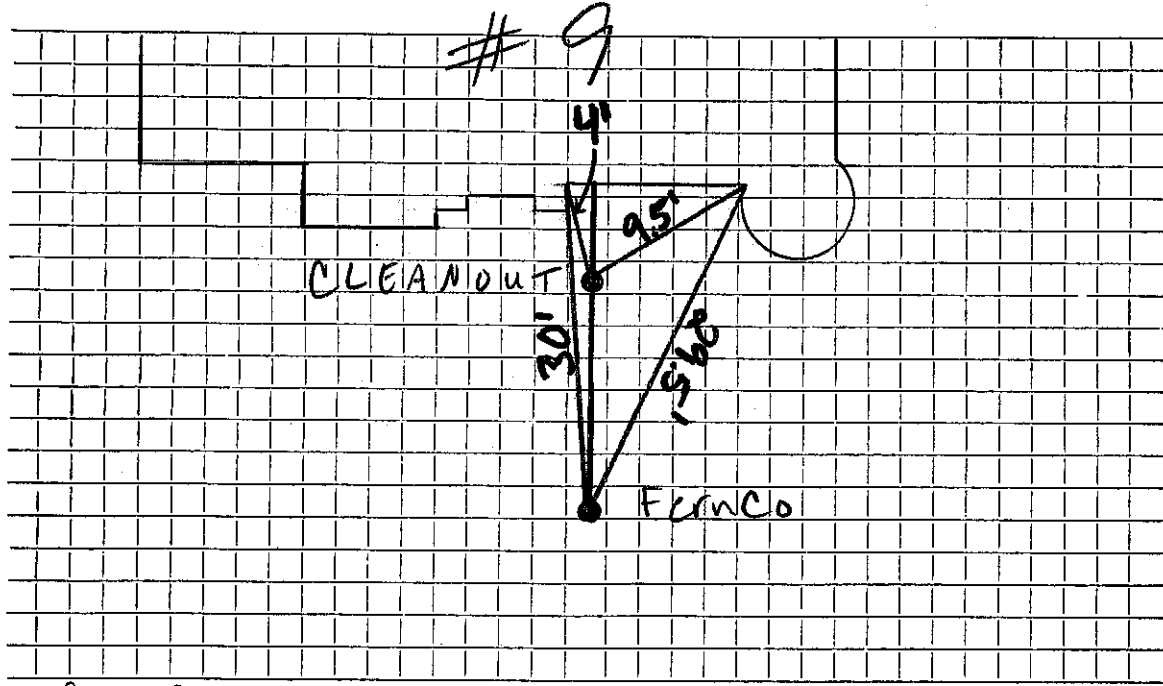

Connection made in Cart Path Lane Street. Work completed

Remarks:
.....
.....