

Name Charles Lavoie

Service No. 33 10-17

Address 19 Carville Avenue

Lexington, Massachusetts

Location 19 Carville Avenue

Kind of Pipe

Size

Size of Main

Repair/Replacement - New Service

Location

| Date | Material | Amount | Total | Date | Amount |
|--------------|---------------------------|--------|-------|-------------|---------------------|
| Nov. 19, '46 | Labor | 13 80 | | Oct. 28 '46 | 100 00 |
| 20, '46 | " | 54 95 | 68 75 | Deposited | |
| | 10% Overhead | | 6 88 | | |
| | 32' - 6" Sewer Pipe @.234 | | 7 49 | | |
| | 1 - 6" Elbow | | 1 28 | | |
| | Joint Compound | | 1 92 | | |
| | Patching 12 x 3 | | 12 00 | | |
| | Trucking 2 hrs. @.75 | | 1 50 | | |
| | | | 99 82 | | |
| | <i>Mandrel</i> | | | | |
| | Labor | | | 11-30-46 | Roof 3 ft from side |

TOWN OF LEXINGTON—DEPT. OF PUBLIC WORKS
SEWER DIVISION

DATE


NO.

The undersigned applies for the construction of a particular sewer connecting No.
Street and hereby agrees to comply with the Rules and Regulations governing the construction and use of Particular
Sewers, as now or at any future time established by the Board of Selectmen.

Am't of estimate \$.....

Am't Paid \$.....

..... Owner

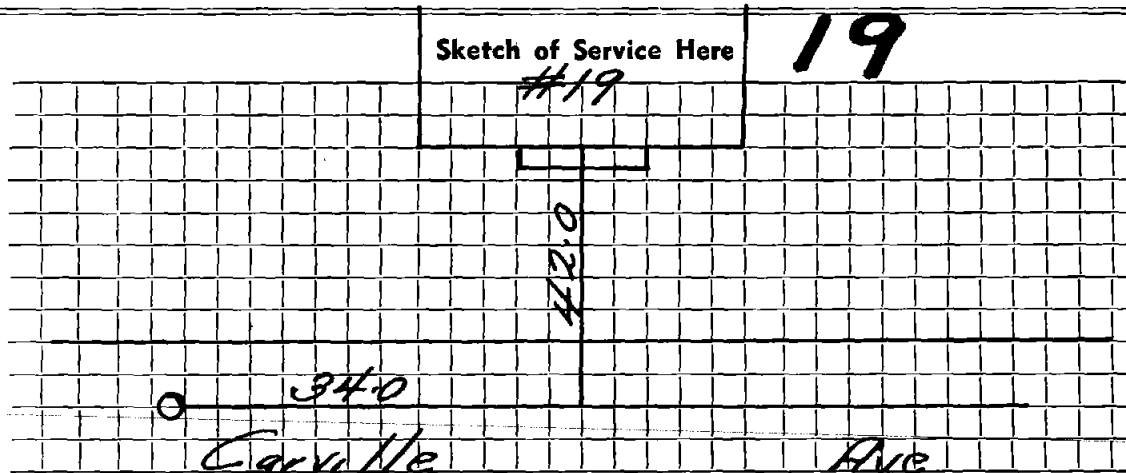

Connection made in Street.

Work completed 19..

Remarks: