

Name N. Y. Brothers Trust

Service No. 73

Address **23 CARVILLE AVE**

Location

Kind of Pipe

Size

Size of Main

~~Repair/Continual~~ - New Service Valeri #3126 W.O.#1087

Location APR 8 1974

Date		Material	Amount	Total	Date	Amount
8/30/73	23'	6" Transite			7-24-73	300 00
	10'	4" Cast Iron			4-8-74	39 81
					6-14-74	48 43
7-26-73		Labor	175.52			386 54
8-7-73		"	23.55	199.07		
		10% O.H.		19.91		
	20'	6" Transite @ .90/ft.		18.00		
	1	6" x 6" tee		7.72		
	1	5' x 6" Nipple w/coupling		1.27		
	1	6" Cap		1.77		
	1	hr. Compressor		5.00		
	1	hr. Roller		2.00		
	3	hrs. Town Shovel @ 6.50		19.50		
	4	hrs. Trucking @ 3.00		12.00		
				<u>\$286.24</u>		


Balance - 486.53

DATE _____

TOWN OF LEXINGTON — BOARD OF PUBLIC WORKS
SEWER DIVISION

Sketch of Service Here

23

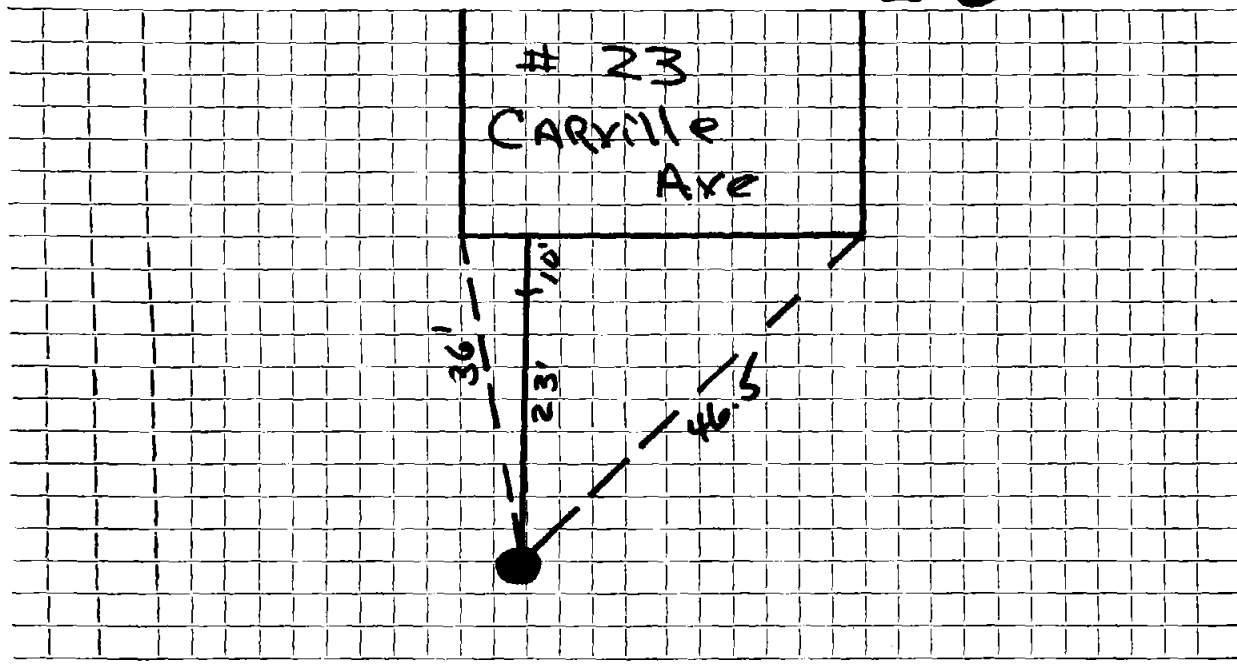

Connection made in Street. Work completed

Remarks:
.
.