

OWN OF LEXINGTON—DEPT. OF PUBLIC WORKS

SEWER DIVISION

NO.

DATE


The undersigned applies for the construction of a particular sewer connecting No.
street and hereby agrees to comply with the Rules and Regulations governing the construction and use of Particular
sewers, as now or at any future time established by the Board of Selectmen.

Am't of estimate \$

Am't Paid \$

..... Owner

Sketch of Service Here

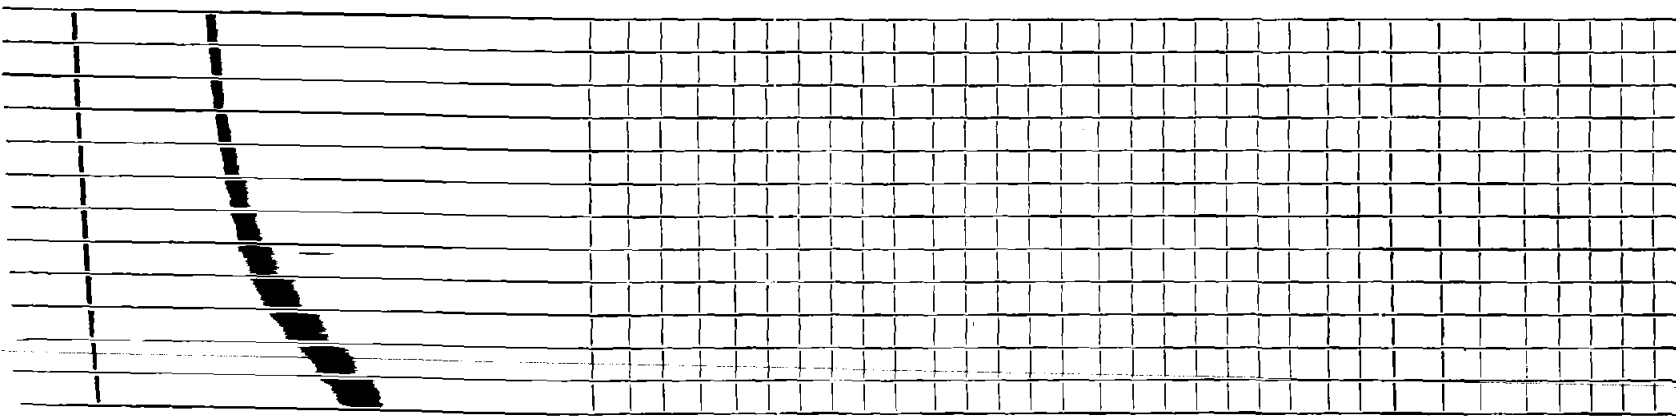

Connection made in Street. Work completed 19..

Remarks:

Name William H. Sullivan

Service No. 132

Address 26 Carville Avenue

Location *Comm. 12-3-56*

Kind of Pipe

Size

Size of Main

~~Repair-Renewal~~ - New Service

Location

Date	Material	Amount	Total	Date	Amount
9/13/56	Labor	83 40		9-13-56	<i>Deposit</i> \$ 200 00
	10% overhead	8 34	91 74	12-3-56	<i>Refund</i> 26 93
	60' - 6" Sewer pipe @ .435		26.10		173 07
	Joint compound		3 60		
	6 hrs. Town Shovel @ 6.50		39 00		
	1 hr. trucking		75		
	1 - 6" Elbow		1 88		
	10x3 patching		10 00		
			173 07		
	Labor				

TOWN OF LEXINGTON—DEPT. OF PUBLIC WORKS
SEWER DIVISION

DATE.....

NO.


The undersigned applies for the construction of a particular sewer connecting No.....
Street and hereby agrees to comply with the Rules and Regulations governing the construction and use of Particular
Sewers, as now or at any future time established by the Board of Selectmen.

Am't of estimate \$.....

Am't Paid \$.....

..... Owner

Sketch of Service Here **26**

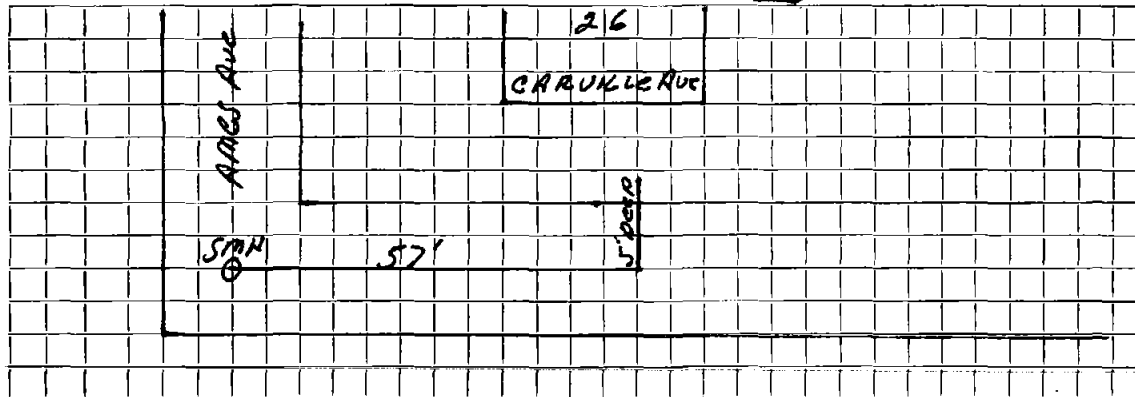

Connection made in..... Street.

Work completed.....19..

Remarks:

