

Name Rosemary G. Sullivan

Service No. 114

Address 30 Carville Avenue

Location

Kind of Pipe

Size

Size of Main

~~Repair~~ Renewal ~~New Service~~ W. O. # 8290

Location APR 26 1972

Date	Material	Amount	Total	Date		Amount
12/7/71	Labor	64 22		11-17-71	Deposit	300 00
12/8/71	"	21 70	85 92	4-26-72	Retard	158 09
	10% O.H.		8 59			141 91
22'	Transite pipe .90		19 80		<u>OUTSIDE</u>	
1	Donut		2 65	12/9/71	Labor	85 36
1	Yd. Loam		3 50	12/10/	"	24 04
2	Lbs. Grass seed 1.10		2 20	12/18/	20' 6" Transite pipe .90	54 00
1	Hr. Trucking		3 00		1 6" Nipple	1 71
2½	Hrs. Shovel 6.50		16 25		1 6" x 6" Nipple	1 28
			141 91		1 90o El	5 65
					1 Ton cold patch	8 00
					1 " hot top	7 45
					1½ Bag cement 1.95	98
					2 Yds. gravel 1.90	3 80
					3 Hrs. Trucking 3.00	9 00
				3½	" Shovel 4.00	14 00
				1	" Roller	2 00
					Trailer	2 00
						237 27


DATE _____

TOWN OF LEXINGTON — BOARD OF PUBLIC WORKS

SEWER DIVISION

Sketch of Service Here

30

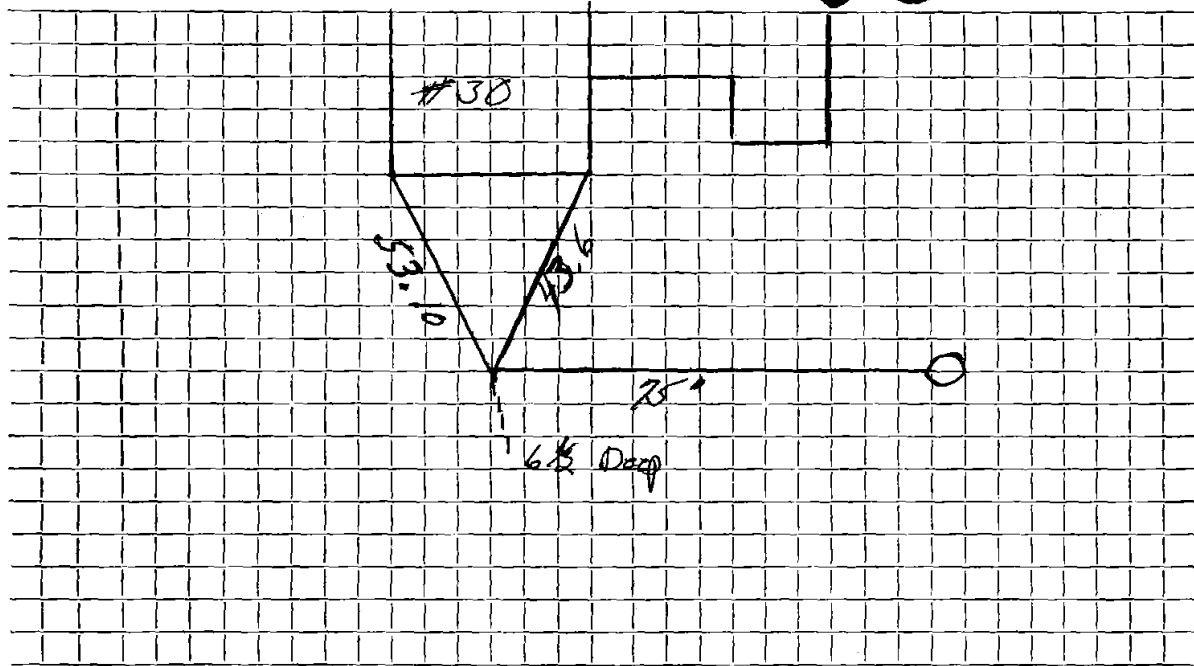

Connection made in Street.

Work completed

Remarks: Original Service 9-15-52