

Name Edmundo Medeiros

Service No. 42

Address 31 Carville Ave.

Location

Kind of Pipe

Size

Size of Main

~~Repair~~ Renewal ~~XXXXXXXXXX~~

WO #4595 John Devine #2839

Location AUG 8 1977

Date	Material	Amount	Total	Date	Amount
6/29/76	labor	116. 11		6-15-76	300. 00
	10%OH	11. 61	127. 72		Deposit
	10' 6" Transite Pipe		14. 80		
	1 6" X 12" Cast Iron Saddle		15. 09		
	1 6" X 6" Elbow		5. 48		
	1 5' X 6" Nipple		7. 80		
	1 6" X 6" Nipple		1. 71		
	2 2' X 6" Nipple @ 5.39		10. 78		
	2 ton cold patch @ 13.70		24. 40		
	½ hr. truck @ 3.00		1. 50		
	1 hr. dump truck		4. 00		
	2 hr. shovel @ 6.50		13.00		
	XXXXX Street 9' X 24' long		144. 00		
			370. 28		
7/20/76	55' 6" transit pipe				
	10' 4" cast iron				10. 00


Bill sent 10. 00

DATE _____

TOWN OF LEXINGTON — BOARD OF PUBLIC WORKS
SEWER DIVISION

Sketch of Service Here

31

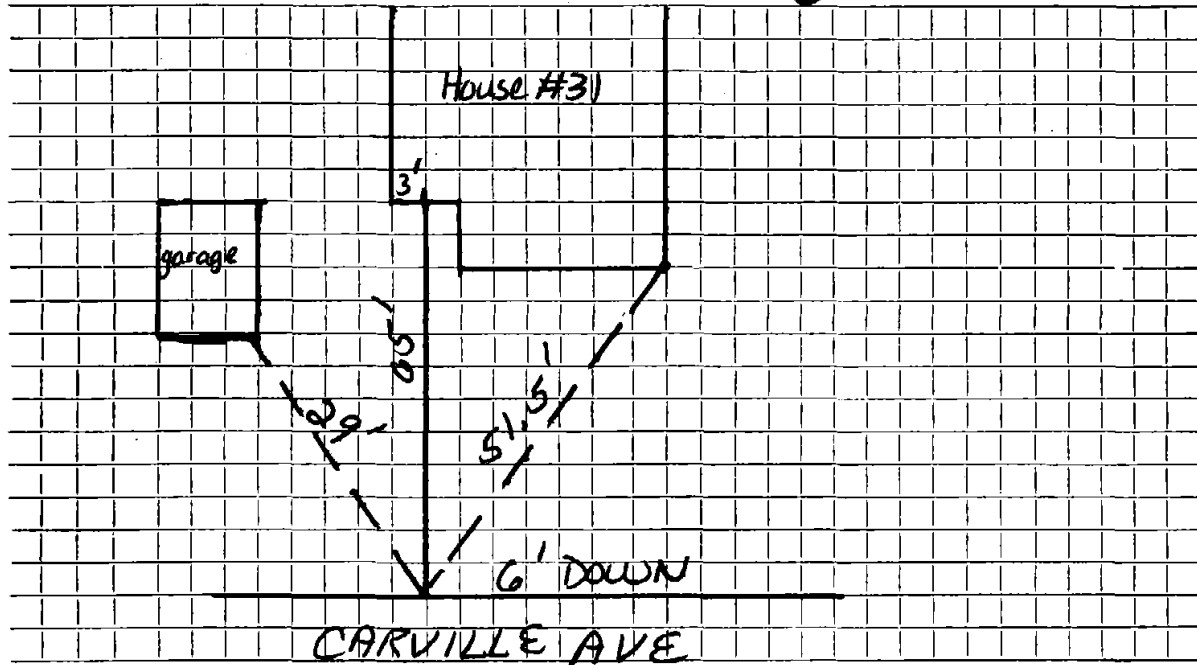

Connection made in Street. Work completed

Remarks:

.....
.....