

Name

Service No.

Address 39 Carville Avenue

Location

Kind of Pipe

Size

Size of Main

~~Repair~~—Renewal—~~New Service~~ Eagle


Location

Date		Material	Amount	Total	Date		Amount
6/28/83	17'	6" P.V.C.					
	1	10" x 6" Saddle w/adpt to P.V.C.					
	1	22 ^o Bend P.V.C.					
						OUTSIDE	
					6/28/83	39'	6" P.V.C.
						3'	4" Cast Iron pipe
							4" x 6" Donut
					6/9/83	17½'	6" PVC Pipe
						1	22½ ^o PVC Bend
						1	6" Transite to PVC Adaptor
						1	6 x 10 Saddle
						1	5' x 12" Cement Drain Pipe
						1	12" Curb Extension

DATE _____

TOWN OF LEXINGTON — BOARD OF PUBLIC WORKS
SEWER DIVISION

Sketch of Service Here **39**

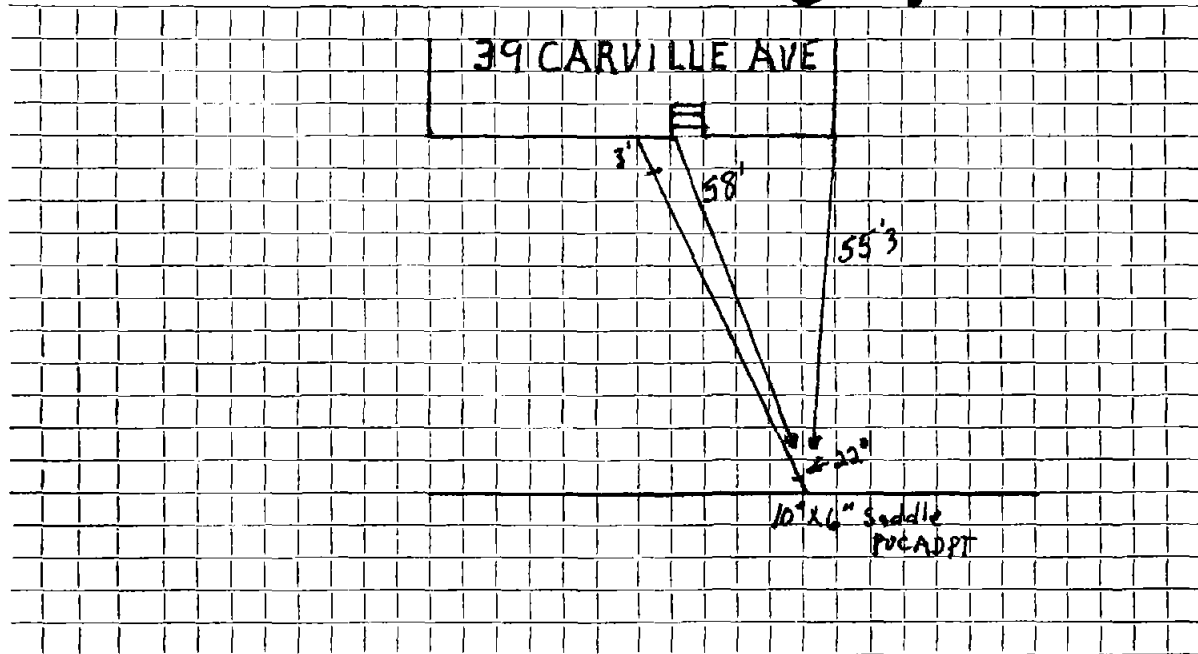

Connection made in Street. Work completed

Remarks:
.....
.....