


DATE JULY 21, 1997

TOWN OF LEXINGTON — BOARD OF PUBLIC WORKS
SEWER DIVISION

Sketch of Service Here **42**

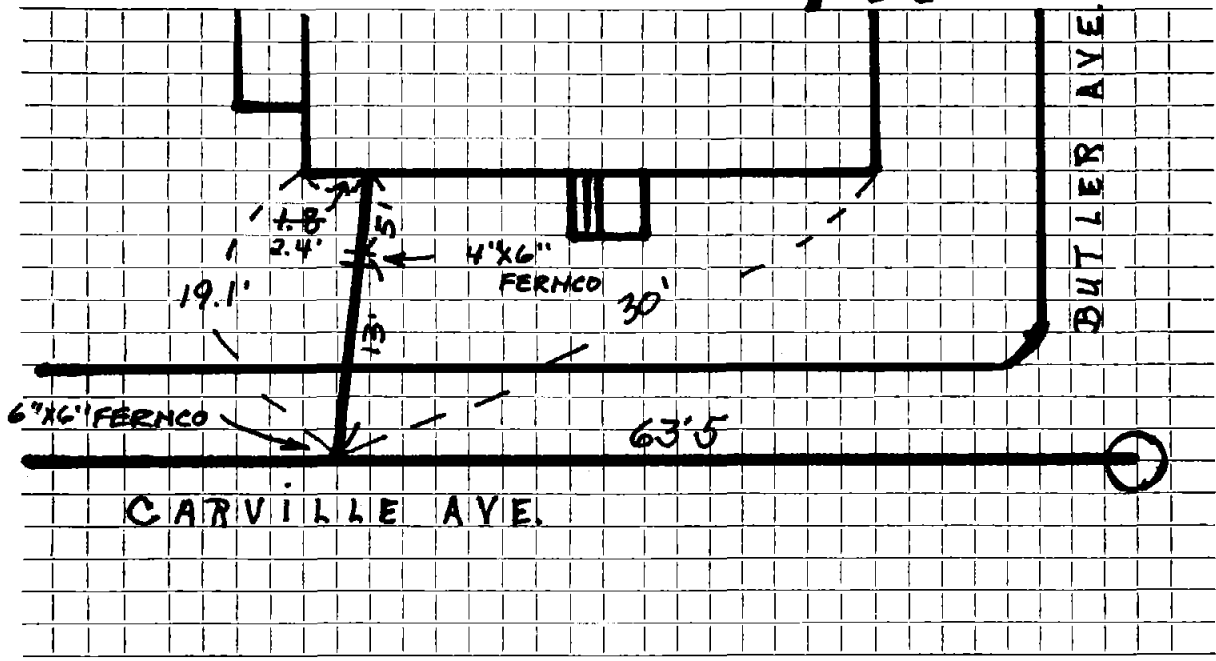

Connection made in CARVILLE AVENUE Street. Work completed

Remarks:

BOOK 97-3

I.W.