


DATE _____

TOWN OF LEXINGTON — BOARD OF PUBLIC WORKS
SEWER DIVISION

Sketch of Service Here **47**

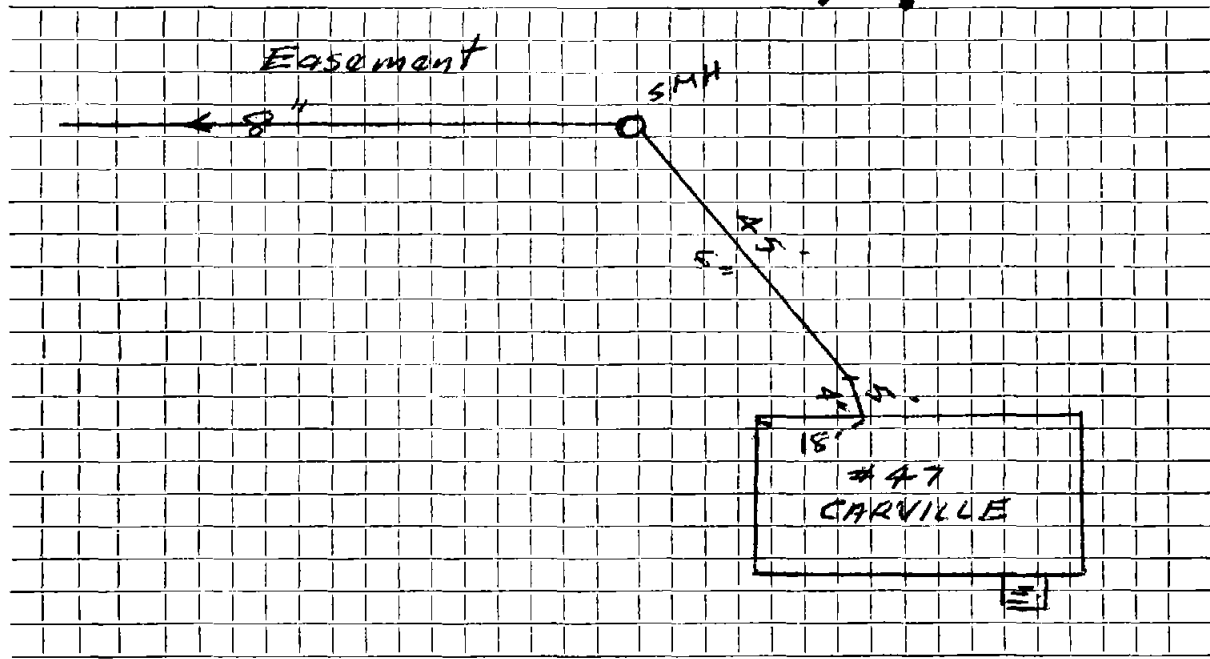

Connection made in Easement Street. Work completed

Remarks: Service direct to SMH

