

Name Ira Bernstein

Service No. 108

Address 53 Carville Ave

Location

Kind of Pipe AC

Size 8"

Size of Main 8"

~~REPAIR WORK~~ New Service Great Northern #3479

Location JAN 21 1980


Date	Material	Amount	Total	Date	Amount
10-4-79	51f4" OF	N.C.		12-5-79	75.40
	51f6" AC @	15.00	= 75.90	Deposit	
8/10/84	SECOND SERVICE				
	14' x 6" PVC				
	10' x 4" PVC				
	1 6" x 4" Donut				
	1 6" x 90° Elbow				
	1 8" x 6" Saddle				

DATE 10-4-79

TOWN OF LEXINGTON — BOARD OF PUBLIC WORKS  
SEWER DIVISION

Sketch of Service Here

53

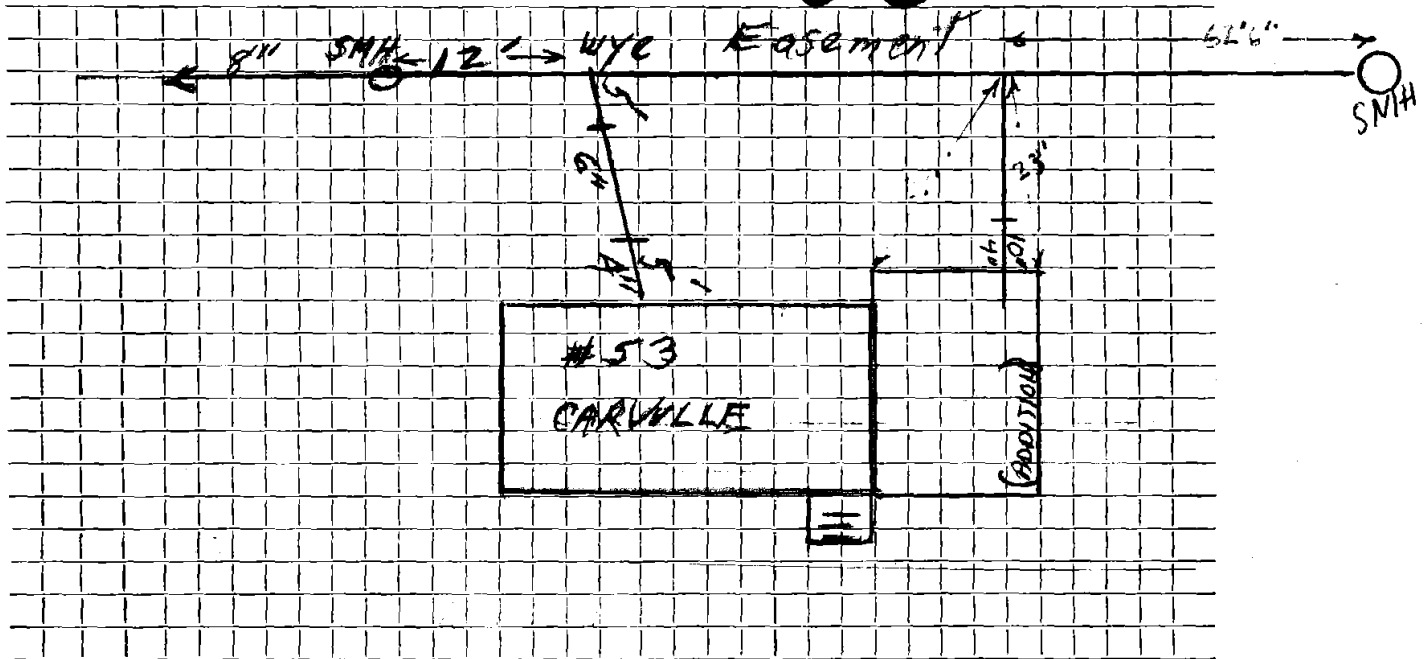

Connection made in Easement Street. Work completed

Remarks: TWO 6" SEWER SERVICES OUT THE BACK INTO 8" EASEMENT