

Name

Service No.

Address 7 Carville Avenue

Location

Kind of Pipe

Size

Size of Main

Repair ~~Renewal~~ ~~New Service~~ W.O. #1622


Location

Date	Material	Amount	Total	Date	Amount
8-21-42	44' 6" Sewer Pipe				
	1 6" Elbow				
					Repair
				3/10/81	Labor
				5/6/81	"
				1	6" x 2' Transite Nipple
				1	6" x 3' Transite Nipple
				1	6" 90° Transite Elbow
				1	6" Fernco Adapter
				6	yds. Gravel
					Patch 10 x 8
				4	hrs. Trucking
				4	hrs. Town Shovel
				1-5-79	solids 32' out
				1-10-68	Pipe Repair
				1-9-68	BROKEN AT Elbow
				12-27-67	Pipe MUST be broken AT Elbow
				10-12-65	RAGS + DEBRIS

DATE _____

TOWN OF LEXINGTON — BOARD OF PUBLIC WORKS
SEWER DIVISION

Sketch of Service Here 

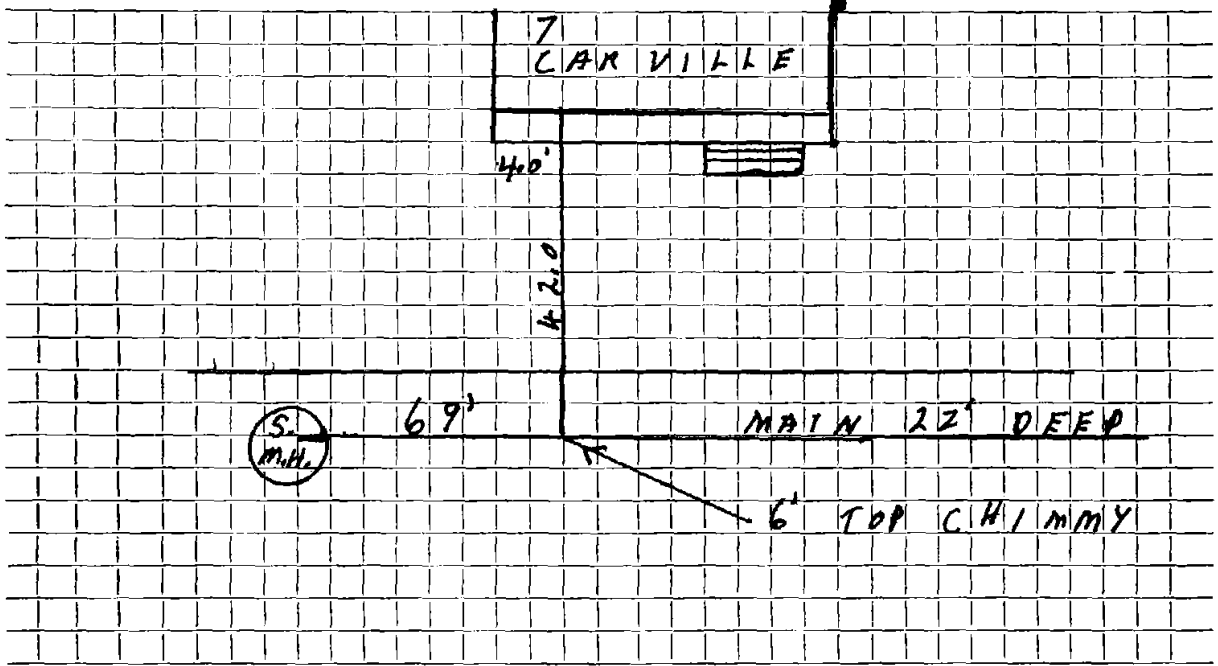

Connection made in Street. Work completed

Remarks: Repaired at Elbow 42' out from house, 69' down from S.M.H. 127' from Oak Street
20' deep to main
Gas 3' off of pavement