


DATE _____

TOWN OF LEXINGTON — BOARD OF PUBLIC WORKS SEWER DIVISION

Sketch of Service Here

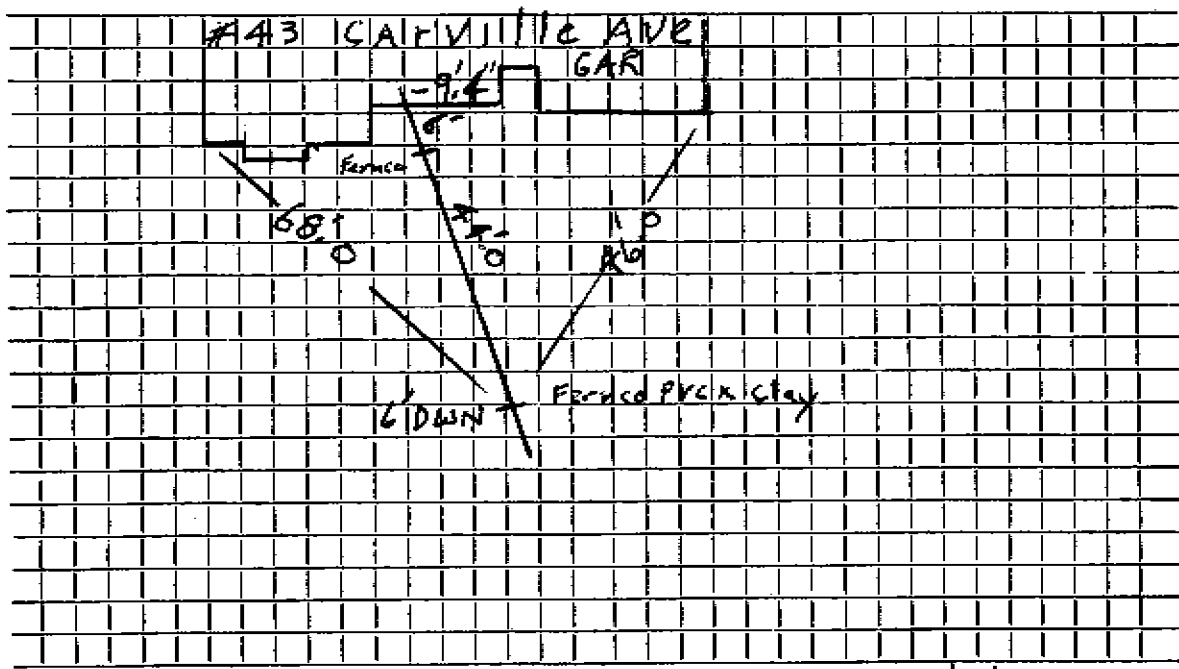

Connection made in Street. Work completed 4/9/08 J. McLaughlin.....

Remarks:
.....
.....